
FORM 51 25M 8-50 WESTERN Sumner KANSAS

Section 3 Township 35 Range 3W

Well No. #1 L. T. Devorak

Company Texas

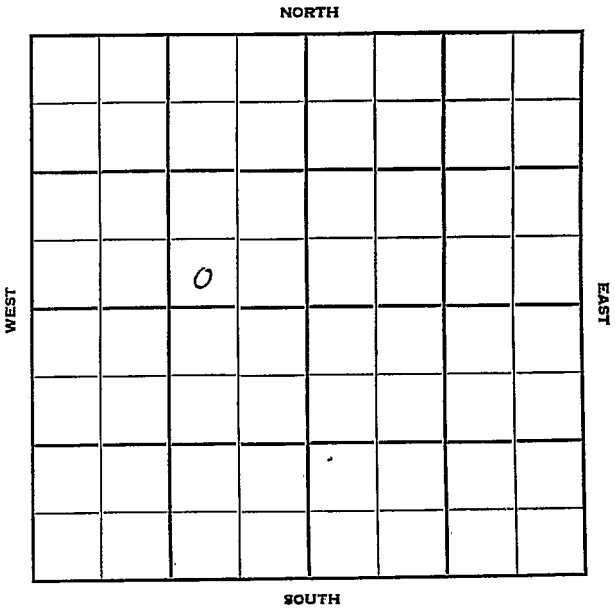

FORM 252-B
10M 10-50 PETROL

KANSAS Sumner

Sec. 3 Twp. 35 R. 3-W

Well No. #1 L. T. Devorak Farm

Texas Company

Stickle Drlg. Contractor


_____ Ft. from N. Line

330 Ft. from S. Line

990 Ft. from E. Line

_____ Ft. from W. Line

SW SE NW

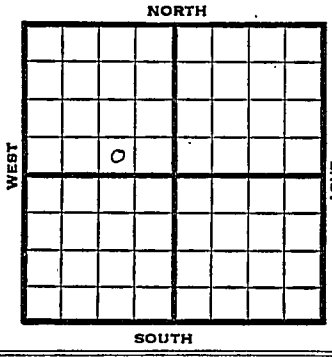

1950	Elev 1150' REPORT
11/1	Spud 10-29-50 Drlg 450
1951 1/10	Spud 10-29-50 10" @ 611 Layton 3610 KC 3656 Miss 4326 Kinderhook 4732 Viola 4805 Simp 4819 DST 4807-28 opn 2 hr rec 350' gas 30' mud DST 4833-60 opn 2 hrs rec 1000' gas 280' o&gcm 450' sw Cored 4860-90 rec 30' sand Cored 4917-53 rec 12' green shale 3' sandy shale 1' shale 5' sh sand 3' sandy shale 4' shale 5' waxey sh & sd Corrected tops: KC 3662 B KC 3864 Cherokee 4084 Miss 4374 Kinderhook 4750 Misenor 4802 Viola 4808 Simp 4818 Cored 5020-47 rec 3' sd & sh Cored 5040-42 rec 42'dol. Cored 5042-46 rec dol sh 5046-47 dol & shale Cored 5047-77 rec 30' hard dol

OVER

1951
1/10 TD 5117
DST 5050-5117
opn 1 hr rec 1650' sw
Arb 5033
5½" @ 4913
CO to 4872
6/4858-60, 16/4848-54 S/4 bwph
18/4838-44, 18/4030-36 500 A
B/½ bwph S/4 bwph, 4/4485-86
B/2/3 bswph 4/4466-67, 9/4386/88
B/2 bwph 24/3718-24
SP 3747 2500 A
S/2½ bwph no oil
Comp for SWD
Abandoned TD 5114'
ABANDONED

FORM 275 FOR SALE BY KANSAS BLUE PRINT CO.


County Sumner State Kansas

Sec. 3 (Blk. Twp.) 35 (Sur. Rge.) 3W Map No.

Operator Texas

Well No. 1 Farm T. T. Devorak

Elev. Location SW SE NW

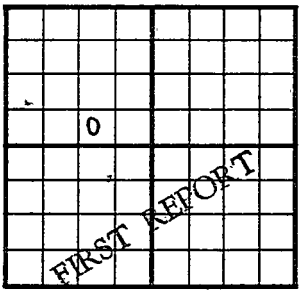

330 Ft. From S Line NW

990 Ft. From E Line Quarter

1st. Report NOV 1 1950

Completion

Remarks Stickle Drlg. - Contr.

Spudding Date 10-29-50

Drlg. Data

drlg. 450

J. E. TYRA

FORM 275 FOR SALE BY KANSAS BLUE PRINT CO.


County Summer State Kansas

Sec. 3 (Blk. Twp.) 35 (Sur. Rge.) 3W Map No.

Operator Texas

Well No. 1 Farm L. T. Devorak

Elev. 1150 Location SW SE NW

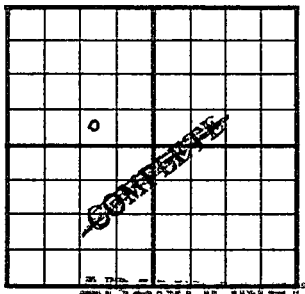

330 Ft. From S Line NW

990 Ft. From E Line Quarter

1st. Report

Completion JAN 1 0 1951

Remarks

Stickle Drlg. - Contr.

Spudding Date 10-29-50

Drlg. Data SWD well TD 5114

10" @ 611 Layton 3610 KC 3656

Miss. 4326 Kinderhook 4732 Viola 4805

Simp. 4819 DST 4807-28 open 2 hr.

Rec. 350' gas 30' mud DST 4833-60

Open 2 hr. Rec. 1000' gas 280' o. & gcm

450' sw - Cored 4860-90 Rec. 30' sand

Cored 4917-53 Rec. 12' green shale

3' sandy shale 1' shale 5' sh. sand

3' sandy shale 4' shale 5' waxey sh. & sd

CORRECTED TOPS

KC 3662 B KC 3864 Cherokee 4084

Miss. 4374 Kinderhook 4750 Misenor 4802

Viola 4808 Simp. 4818 Cored 5020-47

Rec. 3' sd & sh. Cored 5040-42 Rec. 42'

J. E. TYRA

JAN 19 1951

Drlg. Data

dol. - Cored 5042-46 Rec. dol. sh.
5046-47 Dol. & shale Cored 5047-77
Rec. 30' hard dol. TD 5117 DST 5050-5117
open 1 hr. Rec. 1650' sw Arbuckle 5033
5½" @ 4913 CO to 4872 Z 6/ 4858-60
16/ 4848-54 S/ 4 bwph 18/ 4838-44
18/ 4830-36 500 A B/ ½ bwph S/ 4 bwph
4/ 4485-86 B/ 2/3 bswph 4/ 4466-67
9/ 4386-88 B/ 2 bwph 24/ 3718-24
SP 3747 2500 A S/ 2½ bwph no oil
Comp. for SWD