


KANSAS

Section 34 Township 13 Range 14-W

Well No. #5 Driscoll

Company H H Blair

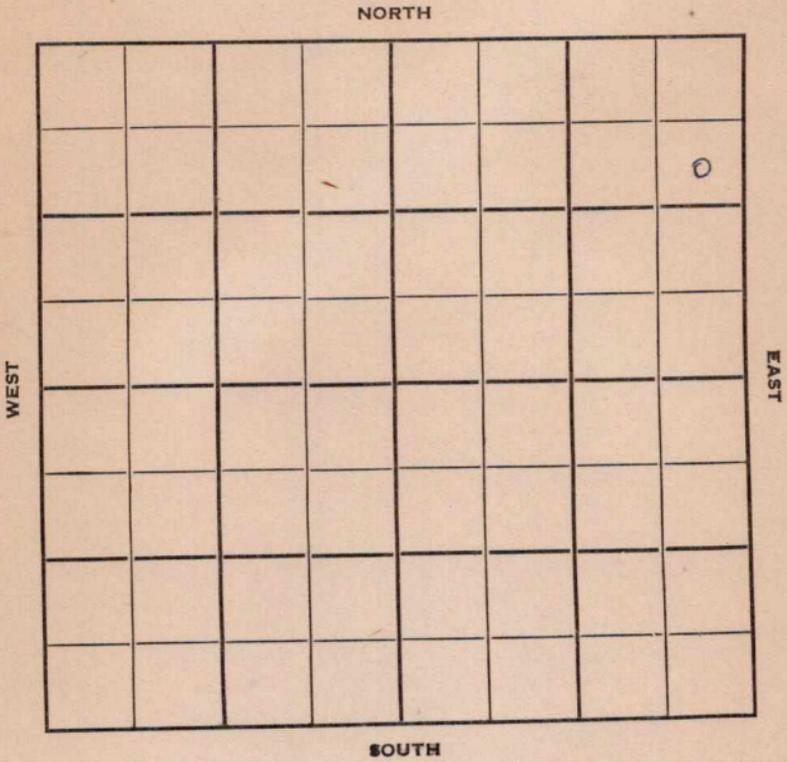

Russell **KANSAS**

Sec. 34 Twp. 13 R. 14W ✓

Well No. #5 Driscoll Farm

H. H. Blair Company

Contractor

Russell Pool


990' Ft. from N. Line

Ft. from S. Line

330' Ft. from E. Line

Ft. from W. Line

SE NE NE

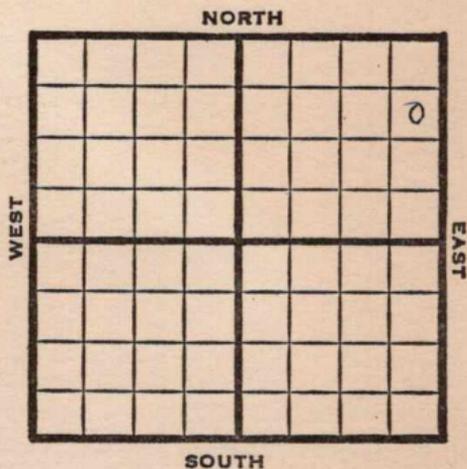

1950

Elev 1834

REPORT

4/5 Location

- 6/14 15 1/2" @ 23
- 13" @ 560
- Anhy 860
- 10" @ 870
- Tarkio 2887
- 8" @ 2508
- Dodge 2957
- KC 2995
- Wtr 3090-3100
- Arb 3289
- TD 3290
- B&A

ABANDONED

Kansas

Russell Pool

Map No. _____ Sec. 34 Twp. 13 R. 14W

Well No. 5 Driscoll

H. H. Blair Company

Contractor

SE NE NE


SECTION PLAT

990 Ft. from N. Line

_____ Ft. from S. Line

330 Ft. from E. Line

_____ Ft. from W. Line

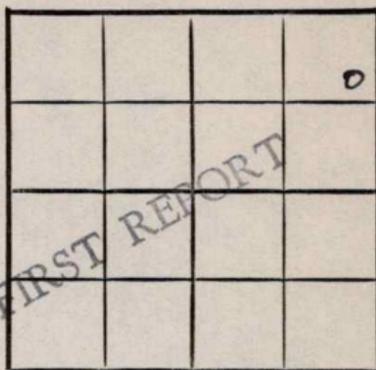

Russell County

Location x

Rig up _____

Drilling and Remarks:

RECORD

Cased _____ in., _____ ft.

Sand _____

Gas _____

Oil _____

Total Depth _____

PRODUCTION

1st 24 hrs. Nat. _____

1st 24 hrs. after shot _____

Gas _____ Cu. Ft.

Dry Hole _____

Abandoned _____

Date

APR 5 1950

J. E. TYRA

Scout

Map No. _____ Sec. 34 Twp. 13 R. 14W

Well No. 5 Driscoll

H. H. Blair

Company

Contractor

SE NE NE


El. 1834
SECTION PLAT

990 Ft. from N. Line

Ft. from S. Line

330 Ft. from E. Line

Ft. from W. Line

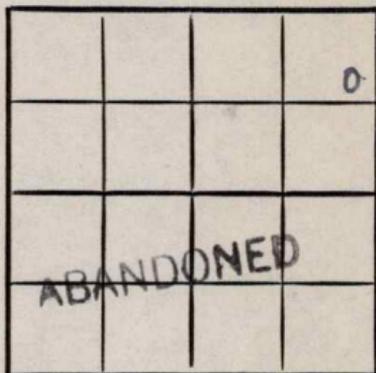

Russell County

Location _____

Rig up _____

Drilling and Remarks:

15 1/2" @ 23

13" @ 560

Anhy 860

10" @ 870

Tarkio 2887

8" @ 2508

Dodge 2957

RECORD

Cased _____ in., _____ ft.

Sand _____

Gas _____

Oil _____

Total Depth 3290

PRODUCTION

1st 24 hrs. Nat. _____

1st 24 hrs. after shot _____

Gas _____ Cu. Ft.

Dry Hole _____

Abandoned _____

Date

JUN 14 1950 19

J. E. TYRA Scout

KC 2995
Water 3090-3100
Arb. 3289
TD 3290

D & A

JUN 19 1950

Scout Cards
Land Small Map
Land Wall Map
Tracings
France Map
Pierce Map
Misc.

74

Drawing and Remarks:
No. of
Location

Production
Total Depth
Oil
Gas
Sand
Gravel

RECORD

SECTION PLAT

Contractor

Company

Well No.

Map No.

735538