

O. W. D. D.

FORM 51 25M 3-49 PETROL

Russell

KANSAS

Section 34 Township 13 Range 14W


Well No. #1 Langholtz

Company ~~B & R Drlg.~~ Jones, Shelburne & Farmer

NORTH

WEST

EAST

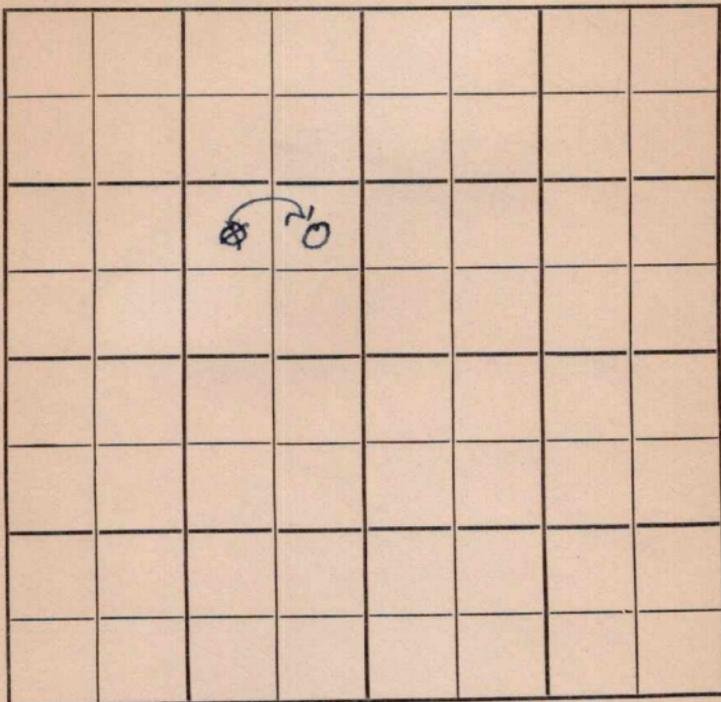

SOUTH

O. W. D. D

Sec. 34 Twp. 13 R. 14 W

Well No. # 1 Langholtz Farm

Jones, Shelburne & Farmer

B & R Drlg. Company

B & R Drlg. Contractor


Ft. from N. Line

990 Ft. from S. Line

~~990~~  
330 Ft. from E. Line

Ft. from W. Line

~~NW SE NW~~  
~~NW SE NW~~

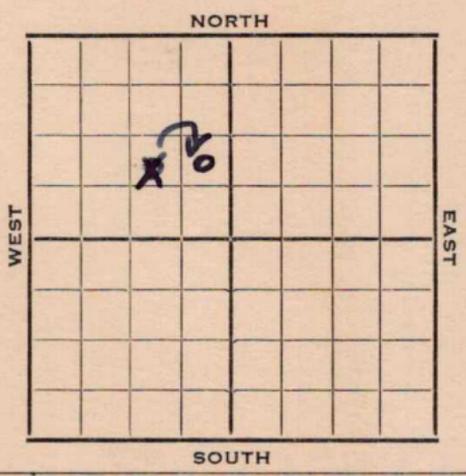

1952 Elev. 1848' REPORT

9/24 Spud 9-22-52

10/1 8" @ 155  
DST 2370-2410 1 hr., 60' M 575# 15"  
DST 2418-27 1 hr., 55' M 10' wtr  
590#  
Drlg. 2490

10/15 Spud 9-22-52  
D&A TD 3330' 8" @ 155  
DST 2370-2410 open 1 hr. rec. 60' mud  
575#  
DST 2418-27 open 1 hr. rec. 55' mud  
10' wtr. 590#  
Tarkio 2387 Top. 2721  
DST 2760-2820 open 1 hr. rec. 23' mud  
Heeb. 2966 Dodge 2973  
KC 3012  
DST 3298-3302 open 1 hr. rec. 50'  
mud Cong. 3298 Reagan 3312  
DST 3308-14 open 1 hr. rec. 15' mud  
DST 3313-30 open 45 min. rec. 1680'  
SW 850# D&A

**ABANDONED**

1956

O. W. D. D

6-6 OTD 3330'  
DD 3412'  
KC. 3012', C. 3298', Reagan 3312'  
TD 3330'

**OVER**

1956

735539

7-3

5½" @ 3390

SWDW, MICT

Takes 8000 BWPD.

Comp. SWD Well

A. 3334', R. Sd. 3396', G. 3491';

TD 3496'

**ABANDONED**

KANSAS

Map No. \_\_\_\_\_ Sec. 34 Twp. 13 R. 14W

Well No. 1 Langholtz

B & R Drlg.


Company

CORRECTION

Contractor

NE SE NW

SECTION PLAT

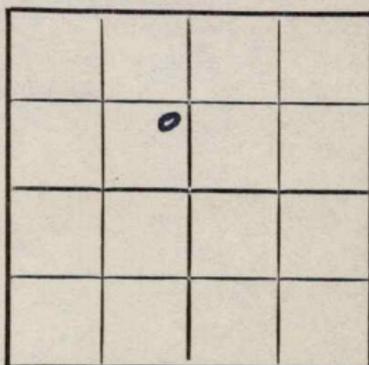

\_\_\_\_\_ Ft. from N. Line

990 Ft. from S. Line

330 Ft. from E. Line

\_\_\_\_\_ Ft. from W. Line

Russell County

Location \_\_\_\_\_

Rig up \_\_\_\_\_

Drilling and Remarks:

Reported

NW SE NW

RECORD

Cased \_\_\_\_\_ in., \_\_\_\_\_ ft.

Sand \_\_\_\_\_

Gas \_\_\_\_\_

Oil \_\_\_\_\_

Total Depth \_\_\_\_\_

PRODUCTION

1st 24 hrs. Nat. \_\_\_\_\_

1st 24 hrs. after shot \_\_\_\_\_

Gas \_\_\_\_\_ Cu. Ft.

Dry Hole \_\_\_\_\_

Abandoned \_\_\_\_\_

Date

OCT 1 1952 19

J. G. McGEHEE Scout




County Russell State Kansas

Sec. 34 (Blk. 13 (Sur. 14W Map No. (Twp.))

Operator B & R Drlg.

Well No. 1 Farm Langholtz

Elev. 1848 Location NE SE NW

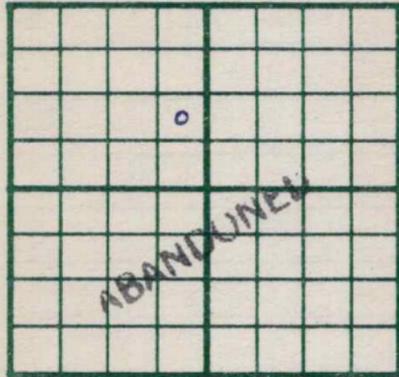

990 Ft. From S Line NW

330 Ft. From E Line Quarter

1st. Report

Completion OCT 15 1952

Remarks

B & R Drlg. - Contr.

Spudding Date 9-22-52

Drlg. Data D & A TD 3330

8" @ 155 DST 2370-2410 open 1 hr.

Rec. 60' mud 575# DST 2418-27

open 1 hr. Rec. 55' mud 10' wtr.

590# Tarkio 2387 Top. 2721 DST 2760-

2820 open 1 hr. Rec. 23' mud Heeb.

2966 Dodge 2973 KC 3012 DST 3298-3302

open 1 hr. Rec. 50' mud Cong. 3298

Regan 3312 DST 3308-14 open 1 hr.

Rec. 15' mud DST 3313-30 open 45 min.

Rec. 1680' sw 850#

D & A

O. W. D. D.

FORM 513 SUNRAY

OWDD

County Russell Elev. \_\_\_\_\_  
 Sec. 34 Twp. 13 Rge. 14W  
 Company Jones, Shelburne & Farmer (was B & R)  
 Farm Name Langholtz No. 1

| TOPS         | DEPTH | LOG | DATUM | Loc. in Sec.  |     |   |    |  |   |  |              |  |  |
|--------------|-------|-----|-------|---|-----|---|----|--|---|--|--------------|--|--|
| Anh.         |       |     |       | NE SE NW  |     |   |    |  |   |  |              |  |  |
| Tp.          |       |     |       |   |     |   |    |  |   |  |              |  |  |
| H.           |       |     |       |   |     |   |    |  |   |  |              |  |  |
| Tr.          |       |     |       |   |     |   |    |  |   |  |              |  |  |
| Dg.          |       |     |       |   |     |   |    |  |   |  |              |  |  |
| Bl.          |       |     |       |   |     |   |    |  |   |  |              |  |  |
| L.           |       |     |       | Geol. _____   |     |   |    |  |   |  |              |  |  |
| K.C.         | 3012  |     |       | Contr. _____  |     |   |    |  |   |  |              |  |  |
| B.K.C.       |       |     |       | J-S-F   |     |   |    |  |   |  |              |  |  |
| Ce.          |       |     |       |   |     |   |    |  |   |  |              |  |  |
| C.           | 3298  |     |       | Pool _____  |     |   |    |  |   |  |              |  |  |
| M.           |       |     |       | Russell   |     |   |    |  |   |  |              |  |  |
| K. Reagan    | 3312  |     |       |   |     |   |    |  |   |  |              |  |  |
| Mz.          |       |     |       | <table border="1"> <tr> <td>JUN</td> <td>6</td> <td>55</td> </tr> <tr> <td></td> <td>0</td> <td></td> </tr> <tr> <td colspan="3">FIRST REPORT</td> </tr> </table> | JUN | 6 | 55 |  | 0 |  | FIRST REPORT |  |  |
| JUN          | 6     | 55  |       |   |     |   |    |  |   |  |              |  |  |
|              | 0     |     |       |   |     |   |    |  |   |  |              |  |  |
| FIRST REPORT |       |     |       |   |     |   |    |  |   |  |              |  |  |
| Me.          |       |     |       |   |     |   |    |  |   |  |              |  |  |
| V.           |       |     |       |   |     |   |    |  |   |  |              |  |  |
| S.           |       |     |       |   |     |   |    |  |   |  |              |  |  |
| S.           |       |     |       |   |     |   |    |  |   |  |              |  |  |
| A.           |       |     |       |   |     |   |    |  |   |  |              |  |  |
| R.           |       |     |       |   |     |   |    |  |   |  |              |  |  |
| PE.          |       |     |       |   |     |   |    |  |   |  |              |  |  |
| G.           |       |     |       |   |     |   |    |  |   |  |              |  |  |
| T.D.         | 3330  |     |       |   |     |   |    |  |   |  |              |  |  |

Date Comm. OTD 3330 DD 3412

*mirrored text*

R.G.

*Handwritten mark*

County Russell Elev. \_\_\_\_\_  
 Sec. 34 Twp. 13 Rge. 14W  
 Company Jones, Shelburne & Farmer (was B & F)  
 Farm Name Langholtz No. 1

| TOPS      | DEPTH | LOG | DATUM | Loc. in Sec. |
|-----------|-------|-----|-------|--------------|
| Anh.      |       |     |       | NE SE NW     |
| Tr.       |       |     |       |              |
| H.        |       |     |       |              |
| Tr.       |       |     |       |              |
| Dg.       |       |     |       |              |
| Bl.       |       |     |       |              |
| L.        |       |     |       |              |
| K.C.      | 3012  |     |       | Geol.        |
| B.K.C.    |       |     |       | Contr.       |
| Ce.       |       |     |       | J-S-F        |
| C.        | 3298  |     |       |              |
| M.        |       |     |       |              |
| M.        |       |     |       | Pool         |
| K. Reagan | 3312  |     |       | Russell      |
| Mz.       |       |     |       |              |
| Mo.       |       |     |       |              |
| V.        |       |     |       |              |
| S.        |       |     |       |              |
| S.        |       |     |       |              |
| A.        | 3334  |     |       |              |
| R. sd     | 3396  |     |       |              |
| Pe.       |       |     |       |              |
| G. -      | 3491  |     |       | ABANDONED    |
| TD 3496   | 3330  |     |       |              |

Date Comm. JUL 3 1956  
 OTD 3330 DD 3412 JUN 13 '56 54' 3390/100  
 SWDN JUN 20 '56 MIST JUN 27 '56 ✓  
 JUL 3 '55 CO TD 3496 (2) takes  
 8000 BWPD  
 comp. S.W.D well