


KANSAS Russell

Section 34 Township 13 Range 14W

Well No. 2 Rusch

Company H.H. Blair

Hall-Gurney
NORTH

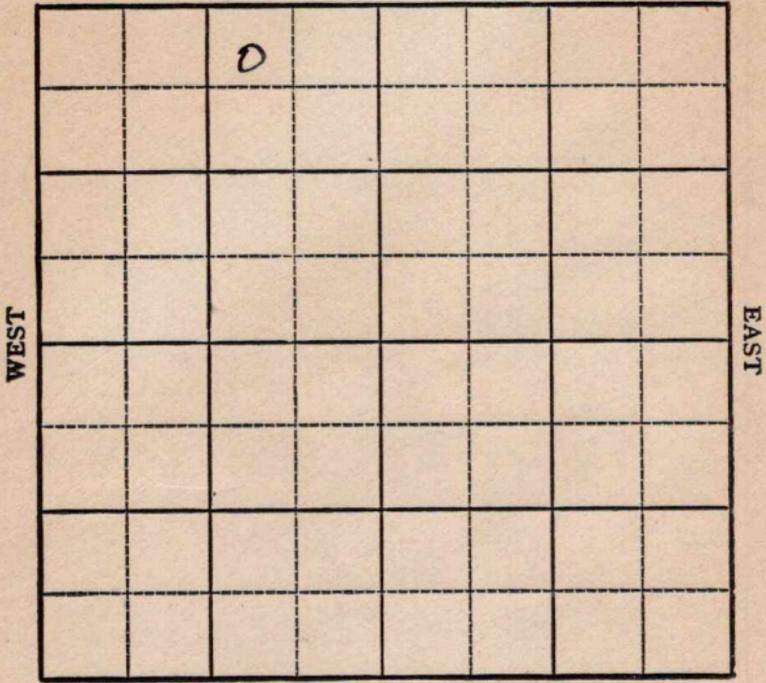

SOUTH

Sec. 34 Twp. 13 R. 14W ✓

Well No. 2 Rusch Farm

H.H. Blair Company
Hall-Gurney


330 Ft. from N. Line

_____ Ft. from S. Line

990 Ft. from E. Line

_____ Ft. from W. Line

NW NE NW

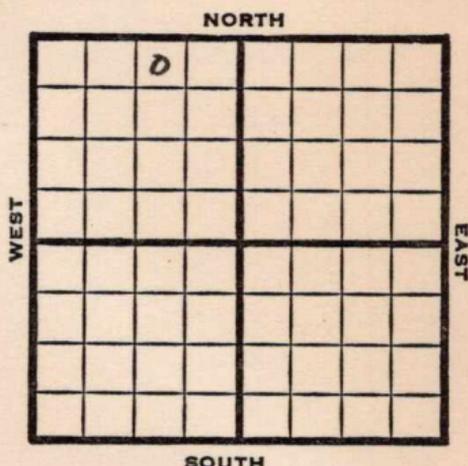

1948 **Elev 1855'** REPORT

11/17 Location

11/23 "

11/30 "

12/8 "

12/15 ^D rlg 150

12/22 8"@ 122'

Drlg 2340'

12/29 2535 SD

1/5 Drlg 2900'

1/12 Varkio 2387, Topeka 2661

Lansing 3010 BKC 3227

Arbuckle 3285 Td 3290-5" @3286

1/19 TD 3295'

2385' oil 12 hrs.

1/26 "

2/2 "

2/9 TD 3295'

Arb. 3285'

5"@ 3286'

Pump 75 oil Pot

40' Gr.

Comp

COMPLETED

Map No. _____ Sec. 34 Twp. 13 R. 14W

Well No. 2 Rusch

H. H. Blair Company

FIRST REPORT

Contractor

NW NE NW

SECTION PLAT

330 Ft. from N. Line

_____ Ft. from S. Line

990 Ft. from E. Line

_____ Ft. from W. Line

	o		

Russell County

Location X

Rig up _____

Drilling and Remarks:

RECORD

Cased _____ in., _____ ft.

Sand _____

Gas _____

Oil _____

Total Depth _____

PRODUCTION

1st 24 hrs. Nat. _____

1st 24 hrs. after shot _____

Gas _____ Cu. Ft.

Dry Hole _____

Abandoned _____

Date

NOV 17 1948 19

S. J. LEWIS Scout

Hall-Gurney

Map No. 192 Sec. 34 Twp. 13 R. 14W

Well No. 2 Rusch

H. H. Blair Company

COMPLETE

Contractor

WNENW

E. 1855

SECTION PLAT

830 Ft. from N. Line

_____ Ft. from S. Line

990 Ft. from E. Line

_____ Ft. from W. Line

	0		

Rusch

Location _____

Rig up _____

Drilling and Remarks:

Cr 3285

5' 3286

Pump 25 oil bot

40 30

RECORD

Cased _____ in., _____ ft.

Sand _____

Gas _____

Oil _____

Total Depth 3285

PRODUCTION

1st 24 hrs. Nat. _____

1st 24 hrs. after shot _____

Gas _____ Cu. Ft.

Dry Hole _____

Abandoned _____

Date

FEB 9 1949 19

S. J. LEWIS

Scout