


Section 7 Township 18 Range 18 W

Well No. # 1 Schnieder

Company Ed H. Adair

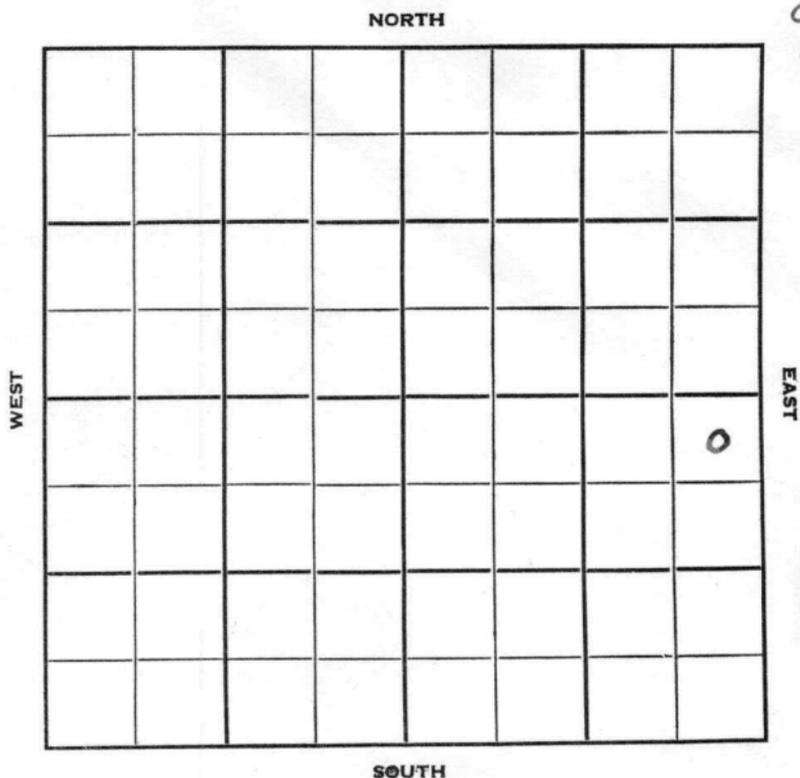

Sec. 7 Twp. 18 R. 18 W

Well No. # 1 Schnieder Farm

Ed H. Adair Company


Adair Contractor

330 Ft. from N. Line

_____ Ft. from S. Line

330 Ft. from E. Line

_____ Ft. from W. Line

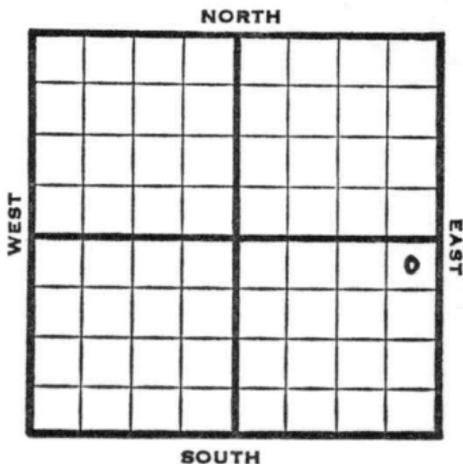

NE NE SE
Carter & Sunray -DHM

1952

Elev. 2102'

REPORT

5/28

Spud 5-24-52
8" @ 288'
Anhy 1265'
Drlg. 1500'

6/11

Spud 5-24-52
D&A TD 3963' 8" @ 288'
Anhy 1265' Top. 3206
Heeb. 3467 Br Lm 3493
Lans. 3515 B KC 3771
Cong. 3887 Arb. 3963
TD 3963' D&A

ABANDONED

3963
2102
1861


County Rush State Kansas

Sec. 7 (Blk. Twp.) 18 (Sur. Rge.) 18W Map No.

Operator Ed H. Adair

Well No. 1 Farm Schnieder

Elev. Location NE NE SE

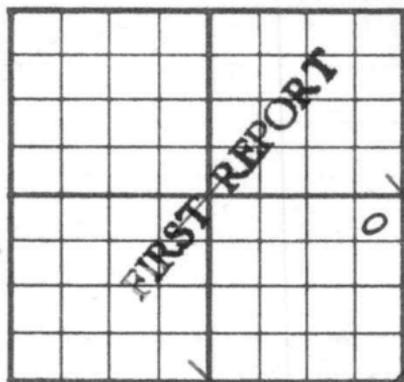

330 Ft. From N Line SE

330 Ft. From E Line Quarter

1st. Report MAY 28 1952

Completion

Remarks Carter & Sunray-DM

Adair - Contr.

Spudding Date 5-24-52

Drlg. Data

8" @ 288 Anhy 1265 Drlg. 1500

J. G. McGEHEE


County Rush State Kansas

Sec. 7 (^{Blk.}_{Twp.}) 18 (^{Sur.}_{Rge.}) 18W Map No.

Operator Ed H. Adair

Well No. 1 Farm Schnieder

Elev. 2102 Location NE NE SE

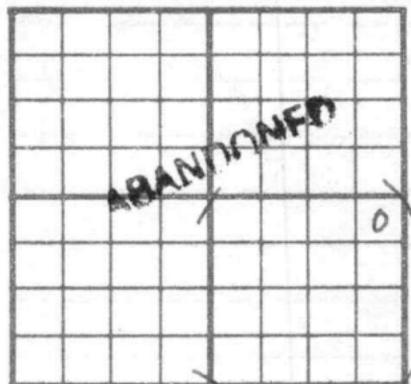

330Ft. From N Line SE

330Ft. From E Line Quarter

1st. Report

Completion JUN 11 1952

Remarks

Adair - Contr.

Spudding Date 5-24-52

Drilg. Data D & A TD 3963

8" @ 288 Anhy 1265 Top. 3206

Heeb. 3467 Br. lime 3493 Lans. 3515

B KC 3771 Cong. 3887 Arb. 3963

TD 3963 D & A