


KANSAS

Russell

Section 34 Township 13 Range 14W

Well No. 1 Driscoll

Company H. H. Blair Drlg.

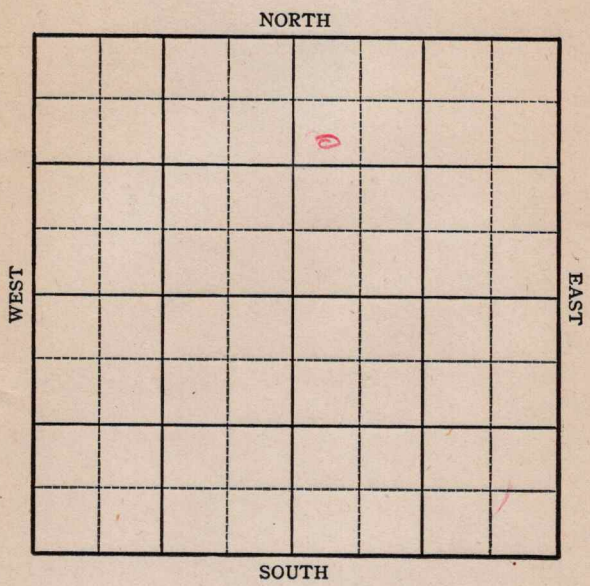

KANSAS

Russell

Sec. 34 Twp. 13 R. 14-W

Well No. #1 Driscoll Farm


H. H. Blair Drlg. Company

1155 Ft. from N. Line

_____ Ft. from S. Line

_____ Ft. from E. Line

330 Ft. from W. Line

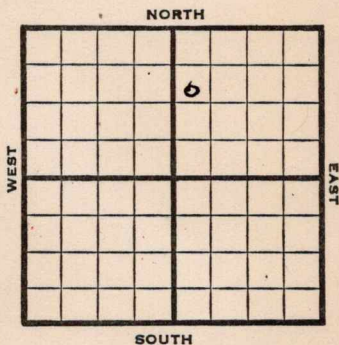

SW NW NE

1945 **Elev. 1844'** REPORT

11/21 Rigging cable tools.
11/28 15" @ 370 WOC
12/5 12½" @ 590
Anhy. 867
10" @ 867
Drlg. 925
12/12 Drlg. 1975
12/20 8" - 2410' Drlg. 2465'
12/29 8" - 2466' **Topeka 2694'**
Drlg. 2785'
1946
1/10 **Dodge 2960-2970'**
Fishing.
1/17 "
1/24 "
1/31 **Lans. 3004'** 7" - 3004'
Drlg. 3150'
2/6 **Gorham 3293**
TD 3325' HFW

ABANDONED


KANSASKansas Pool Name WildcatMap No. 72 Sec. 34 Twp. 13 R. 14WWell No. 1 DriscollH. H. Blair Drlg.

Company

FIRST REPORT

Contractor

SW NW NE

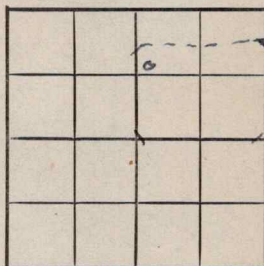SECTION PLAT1155 Ft. from N. Line Ft. from S. Line Ft. from E. Line330 Ft. from W. LineRussell CountyLocation Rig up

Drilling and Remarks:

110 acresRigging cable
tools**RECORD**Cased in., ft.Sand Gas Oil Total Depth **PRODUCTION**1st 24 hrs. Nat. 1st 24 hrs. after shot Gas Cu. Ft.Dry Hole Abandoned

Date

NOV 21 1945 19S. J. LEWIS Scout

KANSASKansas Pool Name WildcatMap No. 72 Sec. 34 Twp. 13 R. 14WWell No. 1 DriscollH. H. Blair Drlg.

Company

ABANDONED

Contractor

E. 1/8 44

SW NW NE

SECTION PLAT

1155 Ft. from N. Line Ft. from S. Line Ft. from E. Line330 Ft. from W. Line

		0	

Russell CountyLocation Rig up

Drilling and Remarks:

Good hole 3293NFW.

RECORD

Cased in., ft.Sand Gas Oil Total Depth 3225

PRODUCTION

1st 24 hrs. Nat. 1st 24 hrs. after shot Gas Cu. Ft.Dry Hole Abandoned

Date

FEB 6 194619S. J. LEWISScout