


DX 78-1

Section 33 Township 19 Range 11 W

Well No. #3 N. J. Schartz

Company Stanolind

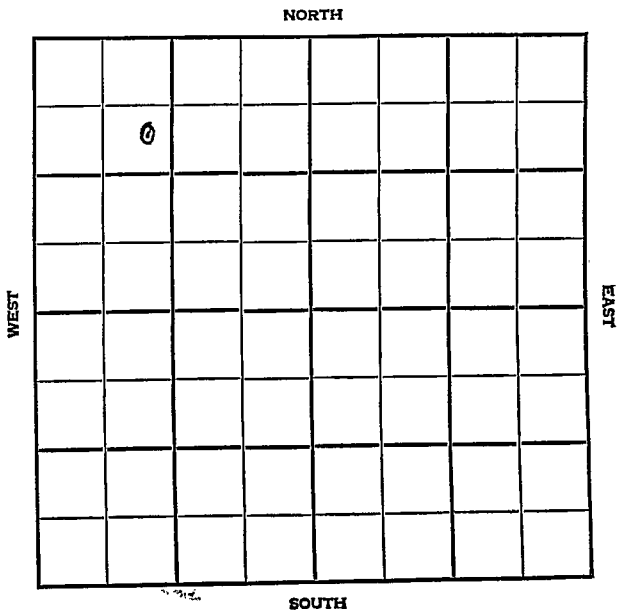

SEC.	TWP.	R.
33	19	11W

WELL NO. #3 N. J. Schartz FARM

COMPANY Stanolind

CONTRACTOR Iron Drlg
Thill


890 Ft. from N. Line

Ft. from S. Line

Ft. from E. Line

1090 Ft. from W. Line

SE NW NW

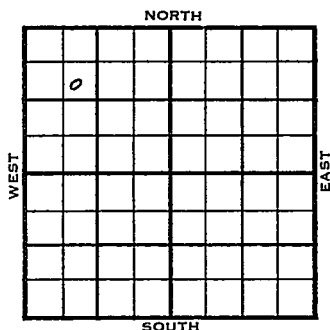

1955

ELEVATION

1783

REPORT

7/27

Location

8/31

Comm 7-26-55

~~Ann 550~~

Anh	550	538
H	2924	2924
Dg sd	2981	2958
B1		3045
L	3026	3064
BKC		3318
A	3339	3339
TD	3343	

8" @ 558/300

DST 2981-3030 open 1/2 hr. Rec 30' drlg mud 180# DST 3080-89 open 1 hr Rec 30' socm 135#

DST 3144-70 open 1 hr Rec 45' mud 880# DST 3194-3214 open 1/2 hr

Rec. 15' mud 0# DST 3340-43 open 45 min. Rec 25' ocm 995# 5 1/2" @ 3340/125 CO to 3343

B/10 goph 500 A S1 1/2 boph 4 hr

1000 A S/5 3/4 boph

Comp 115 bopd

COMPLETED

County Barton Elev. _____
 Sec. 35 Twp. 19 Rge. 11W
 Company Stanolind
 FarmName No. J. Schertz No. 5

TOPS	DEPTH	LOG	DATUM
Anh.			
Tp.			
H.			
Tr.			
Dg.			
Bl.			
L.			
K.C.			
B.K.C.			
Ce.			
C.			
M.			
M.			
K.			
Mz.			
Ma.			
V.			
S.			
S.			
A.			
R.			
PE.			
G.			
T.D.			

Loc. in Sec. SE NW NW
890' NL
1090' WL
 Geol. _____
 Contr. _____
Iron Drlg.
 Pool _____
Thill

FIRST REPORT
 JUL 27 59

Date Comm. _____
 Location _____

Handwritten signature/initials

Co.
 Use.
 No.
 Sec.
 T.
 R.

County Barton Elev. 1783
 Sec. 33 Twp. 19 Rge. 11W
 Company Stanolind
 Farm Name N. J. Schartz No. 3

TOPS	DEPTH	LOG	DATUM	Loc. in Sec.
Anh.	550	538		SE NW NW
Tr.				
H.	2924	2924	1141	890' NL
Tr.				
Dg. <u>sd</u>	2981	2958	1175	1090' WL
BL.		3045	1262	
L.	3024	3064	1281	
K.C.				Geol.
B.K.C.		3318	1535	Contr.
Ce.				Iron Drlg.
C.				
M.				Pool
M.				Thill
K.				
Mz.				
Me.				
V.				
S.				
S.				
A.	3339	3339	1536	COMPLETE
R.				
PE.				
G.				
T.D.	3343			

Date Comm. 7-26-55 AUG 21 1955
 8" @ 558/300" DST 2981-3030 open $\frac{1}{2}$ hr.
 Rec. 30' drlg. mud 180# DST 3080-89
 open 1 hr. Rec. 30' socm 135#
 DST 3144-70 open 1 hr. Rec. 45' mud
 880# DST 3194-3214 open $\frac{1}{2}$ hr. Rec.
 15' mud 0# DST 3340-43 open 45 min.
 Rec. 25' ocm 995# 5 $\frac{1}{2}$ " @ 3340/125
 GO to 3343 B/ 10 goph 500 A

OVER

S/ $1\frac{1}{2}$ boph 4 hr. 1000 A S/ 5 $\frac{3}{4}$ boph
Comp. 115 bopd

_____	Misc.
_____	Pierce Map
_____	France Map
_____	Tracings
_____	Land Wall Map
_____	Land Small Map
_____	Scout Cards

mmmm

SEP 8 1955