

Section 34 Township 13 Range 14W

Well No. #4 Driscoll

Company H. H. Blair

NORTH

							0

WEST

EAST

SOUTH

KANSAS

Russell ✓

Sec. 34 Twp. 13 R. 14-W

Well No. #4 Driscoll Farm _____


H H Blair Company
Hall-Gurney Pool

_____ Ft. from N. Line

990 Ft. from S. Line

330 Ft. from E. Line

_____ Ft. from W. Line

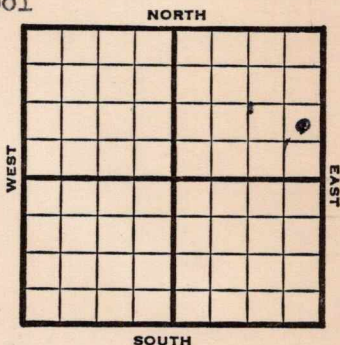

NE SE NE

1950

Elev 1839' REPORT

2/22

Location

4/26

TD 3276'
 13" @ 440'
 10" @ 557'
Tarkio 237080
 Show of gas
 8½" @ 2500
KC 2997'
Arb. 3283'
 TD 3276
 SSO
 5" @ 3273
 DD 3276
 500 acid
 Fu 1500' oil
 Comp 50 BOPD
 Comp

COMPLETED

Map No. _____ Sec. 34 Twp. 13 R. 14W

Well No. 4 Driscoll

H. H. Blair Company

Contractor

NE SE NE

SECTION PLAT

_____ Ft. from N. Line

990 Ft. from S. Line

330 Ft. from E. Line

_____ Ft. from W. Line

			0

FIRST REPORT

Russell County

Location x

Rig up _____

Drilling and Remarks:

RECORD

Cased _____ in., _____ ft.

Sand _____

Gas _____

Oil _____

Total Depth _____

PRODUCTION

1st 24 hrs. Nat. _____

1st 24 hrs. after shot _____

Gas _____ Cu. Ft.

Dry Hole _____

Abandoned _____

Date

FEB 22 1950 19

J. E. TYRA Scout

Map No. _____ Sec. 34 Twp. 13 R. 14W

Well No. 4 Driscoll

H. H. Blair Company

Contractor

NE SE NE


E. 1839
SECTION PLAT

_____ Ft. from N. Line

990 Ft. from S. Line

330 Ft. from E. Line

_____ Ft. from W. Line

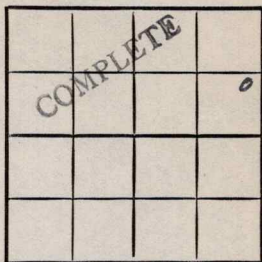

Russell County

Location _____

Rig up _____

Drilling and Remarks:

13" c 440
10" c 557
2arkis 2370-80
Show of gas
8 1/2" c 2500
K.C. 2997
ash. 3273
T.D. 3276

Date _____

RECORD

Cased _____ in., _____ ft.

Sand _____

Gas _____

Oil _____

Total Depth 3276

PRODUCTION

1st 24 hrs. Nat. _____

1st 24 hrs. after shot _____

Gas _____ Cu. Ft.

Dry Hole _____

Abandoned _____

APR 26 1950 19

J. E. TYRA Scout

SSO
5" @ 3273
DD 3276
500 acid
74 1500' oil
Comp. 50

Scout Cards
Land Small Map
Land Wall Map
Tracings
France Map
Pierce Map
Misc.

MAY 3 1951

Drilling and Remarks:
Bore hole
Location

Oil
Gas
Sand
Gravel

RECORD

ft from W line
ft from E line
ft from S line
ft from N line

SECTION PLAT

Contractor

Company

735571