

Barber

KANSAS

Section 23 Township 31 Range 13WWell No. #1 NurseCompany Champlin Ref.

NORTH

WEST

EAST

							0

SOUTH

Barber

Sec. 23 Twp. 31 R. 13WWell No. #1 Nurse Farm


Champlin Ref. Company

Glenn Nye Contractor

Wildcat

330 Ft. from N. Line Ft. from S. Line330 Ft. from E. Line Ft. from W. Line

NE NE NE

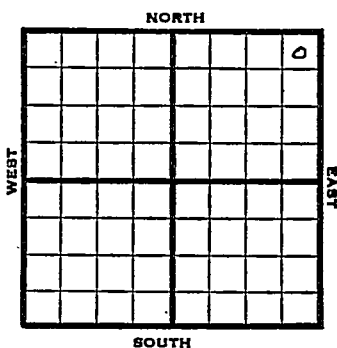

1953

Elev. 1628' REPORT

2/18

Spudding Date
8" @ 207 Drlg. 1350

2/26

Heeb 3526 Doug 3600 DST 3572-3639 10 min
gas in 4" est 10 to 15 M gas 470' gcm
90' SOCM 1445# DST 3572-3639 15 mins
Gassy 2, 420,000 273' V HOCM 1375#
Lans. 3737 Drlg. 3826

3/12

Miss 4217
DST 3950-60, 1 hr., 180' OCM,
480' gas, 695#
DST-4025-36, 1 hr., 270' SW
1470#
DST 4214-35, 2 hrs., 460' GCM,
800#
B Miss 4353
DST 4214-24, 1½ hrs., gas in
50", 30' gcm, 990#
V. 4463, Simp sha 4543, Simp
sd 4555
DST 4539-65, 1/2 hrs., 15' M
1400#
Arb 4651,
DST 4645-4705, 1/2 hrs., 15' M
1395#
TD 4705
5" @ stuck @ 3100
5" @ 4314'

3/19

OVER

1953
 3/26 92/4216-39 750 A 17/3952-56
 wtr & SSO 1000 A No help
 1000 A S/8 BW Plug 3774
 9/3599-3603 3/4 M gas plus water
 3 BW plus SO 4,035,000 14 hrs.
 4/2 NR
 4/9 NR
 4/16 "
 4/23 "
 4/30 "
 5/7 NR
 5/13 Spud 2-13-53 Shut in gas well
 TD 4705' 8" @ 207 Heeb 3526'
 Doug 3600
 DST 3572-3639 open 10 min gas in 4 min
 10 to 15 MCFG 470' gcm, 90' SOGM
 1445#
 DST 3572-3639 open 15 min, 2,420,000
 gas, 273' VHOGM 1375#
 Lans. 3737' Miss 4217'
 DST 3950-60 open 1 hr rec 180' OGM
 480' gas 695#
 DST 4025-36 open 1 hr rec 270' SW
 1470#
 DST 4214-35 open 2 hr red 460' GCM
 800# B. Miss 4353'
 DST 4214-24 open 1½ hr gas in 50 min
 rec 30' GCM, 990# Viola 4463'
 Simp sh. 4543' Simp. sd 4555'
 DST 4539-65 open ½ hr rec 15' mud
 1400# Arb. 4651'
 DST 4645-4705' open ½ hr rec 15' mud
 1395# TD 4705' 5" @ 4314
 92/4216-39 750 A 17/3952-56 wtr &
 SSO 1000 A No help 1000 A
 S/8 BW SP 3774 9/3599-3603 1/ MCFG
 12/3599-3603 3/4 MCFG S/3 BW & SO
 Comp. 4,035,000 gas. Shut in well.

COMPLETED

County Barber State Kansas
 Sec. 23 (Blk. Twp.) 31 (Sur. Rge.) 13W Map No. _____
 Operator Champlin Ref.
 Well No. 1 Farm Nurse
 Elev. _____ Location NE NE NE

						0

FIRST REPORT


330 Ft. From N Line NE
330 Ft. From E Line Quarter
 1st. Report FEB 18 1953
 Completion _____
 Remarks Glenn Nye - Contr.
 Spudding Date 2-13-53

Drlg. Data Wildcat

8" @ 207 drlg. 1350

J. G. McGEHEE

County Barber State Kansas
 Sec. 23 (Blk. Twp.) 31 (Sur. Rge.) 13W Map No.
 Operator Champlin Ref.
 Well No. 1 Farm Nurse
 Elev. 1628 Location NE NE NE

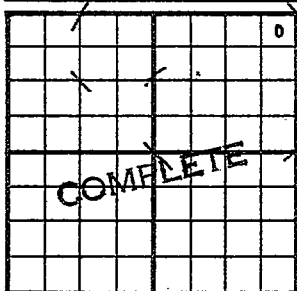

330 Ft. From N Line NE
330 Ft. From E Line Quarter
 Ist. Report
 Completion MAY 13 1953
 Remarks Wildcat
Glenn Nye - Contr.
 Spudding Date 2-13-53

Drlg. Data Shut in gas well TD 4705
8" @ 207 Heeb. 3526 Doug. 3600
DST 3572-3639 open 10 min. gas in 4 min.
10 to 15 mcfg 470' gcm 90' socm 1445#
DST 3572-3639 open 15 min. 2,420,000 gas
273' whocm 1375# Lans. 3737 Miss. 4217
DST 3950-60 open 1 hr. - Rec. 180' ocm
480' gas 695# DST 4025-36 open 1 hr.
Rec. 270' sw 1470# DST 4214-35 open
2 hr. Rec. 460' gcm 800# B. Miss. 4353
DST 4214-24 open 1½ hr. gas in 50 min.
Rec. 30' gcm 990# Viola 4463
Simp. sh. 4543 Simp. sd. 4555
DST 4539-65 open ½ hr. Rec. 15' mud
1400# Arb. 4651 DST 4645-4705

J. G. McGEHEE

Drlg. Data

open $\frac{1}{2}$ hr. Rec. 15' mud. 1395#

TD 4705 5" @ 4314 92/ 4216-39

750 A 17/ 3952-56 wtr. & SSO 1000 A

no help 1000 A S/ 8 bw SP 3774

9/ 3599-3603 $\frac{1}{2}$ mcfg 12/ 3599-3603

3/4 mcfg S/ 3 bw & SO

Comp. 4,035,000 gas Shut in well

MAY 19 1953

_____	MISC.
_____	Pierce Map
_____	France Map
_____	Tracings
_____	Land Wall Map
_____	Land Small Map
_____	Scout Cards

tee