Barber **KANSAS**

SECTION 13 TOWNSHIP 31 RANGE 13 ~~W~~ E

WELL NO. #1 ~~#1~~ Jeff Long

COMPANY Magnolia Pet.

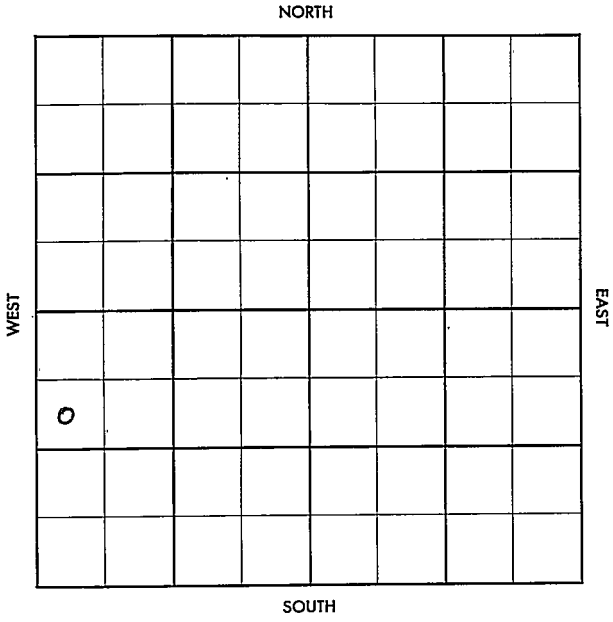

Barber KANSAS

SEC.	TWP.	R.
13	- 31	13W

WELL NO.

#1 Jeff Long FARM

COMPANY

Magnolia Petr.

CONTRACTOR

Bass

Nurse

_____ Ft. from N. Line

_____ Ft. from S. Line

_____ Ft. from E. Line

_____ Ft. from W. Line

SW NW SW

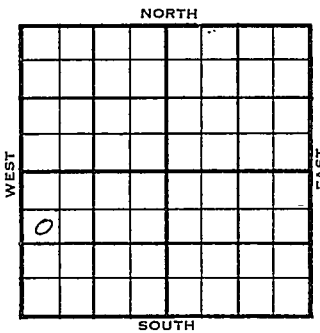

1956	ELEVATION 1616'	REPORT
1-5	MIR	
5-9	Comm. 1-5#-56 9 5/8" @ 314/275 DST 3570-3600 op 1 hr. gas in 9 min. 1,200 mcfg, rec. 960' gcsw, 1375/20". 5½" @ 3724 CO to 3687, 8/3573-75, 8/3576-78, 12/ 3581-84, 10 mcfg, 42 M-A, 28 mcfg, 1000 A, 149 mcfg, frac, 1,200 mcfg, 10 hrs., open flow 734 mcfg, 250 A, 1/ 3584-85 SP 3548, 186 mcfg, frac, open flow 122 mcfgpd, D & A Dg. 3576', L. 3706'. TD 3725'. **ABANDONED**	

DX-78

FORM 513 REV. SUNRAY

County Barber Elev.

Sec. 13 Twp. 31 Rge. 13W

Company Magnolia Pet.

Farm Name Jeff Long No. 1

TOPS	DEPTH	LOG	DATUM
Anh.			
T.P.			
H.			
Tr.			
Dg.			
B.L.			
L.			
K.C.			
B.K.C.			
Ce.			
C.			
M.			
M.			
K.			
Mz.			
Mg.			
V.			
S.			
S.			
A			
R.			
P€.			
G.			
T.D.			

Loc. in Sec. SW NW SW

Geol.

Contr. Bass

Pool Nurse

FIRST REPORT

JAN 5 '56

Date Comm. M I R

Co. Lse. No. Sec. T. R.

FORM 513 REV. SUNRAY

County Barber Elev. 1616

Sec. 13 Twp. 31 Rge. 13W

Company Magnolia Pet.

FarmName Jeff Long No. 1

TOPS	DEPTH	LOG	DATUM
Anh.			
Tp.			
H.			
Tr.			
Dg.	3576		1960
B.L.			
L.	3706		2090
K.C.			
B.K.C.			
Ce.			
C.			
M.			
M.			
K.			
Mz.			
Mg.			
V.			
S.			
S.			
A			
R.			
P€.			
G.			
T.D.	3725		

Loc. in Sec. SW NW SW

Geol.

Contr. Bass

Pool Nurse

ABANDONED

b

MAY 9 1956

Date Comm. 1-5-56

9 5/8" @ 314/275 DST 3570-3600

open 1 hr. gas in 9 min. 1,200 mcfg

rec. 960' gcsw 1375/20" 5½" @ 3724

CO to 3687 8/3573-75 8/ 3576-78

12/ 3581-84 10 mcfg 42 M-A

28 mcfg 1000 A 149 mcfg frac

1,200 mcfg 10 hr. open flow 734 mcfg

250 A 1/ 3584-85 SP 3548 186 mcfg

Co. Lse. No. Sec. T. R.

frac open flow 122 mcfgpd

D & A

R. G.

MAY 2 2 1956