
Barber **KANSAS**

SECTION 13 TOWNSHIP 31 RANGE 13 W

WELL NO. #1 Gress

COMPANY Ed Adair

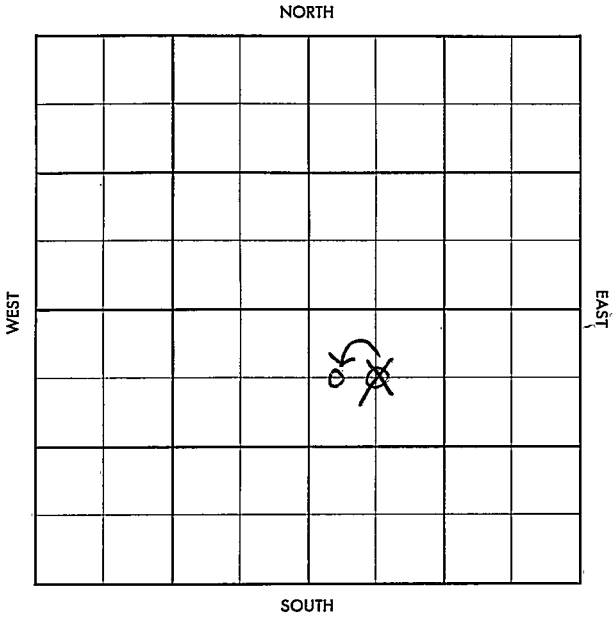

Barber KANSAS

SEC.	TWP.	R.
13 -	31	13W

WELL NO.

#1 Gress FARM

COMPANY

Ed Adair

CONTRACTOR

Co. Tools

Nurse Pool

_____ Ft. from N. Line


_____ Ft. from S. Line

_____ Ft. from E. Line

_____ Ft. from W. Line

~~C NW SE~~

C W/2 NW SE

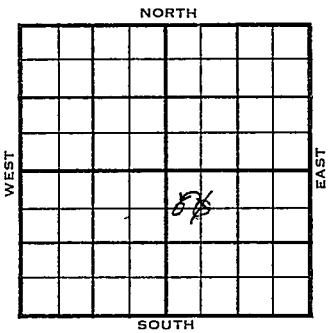

1955	ELEVATION 1578	REPORT
12-7	Comm. 11-30-55 Drlg. 2110'	
12-21	8 5/8" @ 166/135 DST 3529-45 op 1 hr. rec. 5' mud DST 3545-70 op 1 hr. rec. 1500' gassy sw, 1340/20" DST 4890- 3902 op 1 hr. rec. 60' o&gcm 30' wm, 30' sw, 1100/20" DST 3992-4002 op 1 hr. rec. 1880' GIP 180' gcsw, 120' gassy sw, 1380/20" DST 4120-59 op 1 hr. gas to surface in 40 min. rec. 4085' GIP, rec 85' so&gcm 420/20" D & A Sd. 3548 L. 3671 M. 4159 TD 4190'	

ABANDONED

DX-78

FORM 513 REV. SUNRAY

County Barber Elev.

Sec. 13 Twp. 31 Rge. 13W

Company Ed Adair

Farm Name Gress No. 1

TOPS	DEPTH	LOG	DATUM
Anh.			
T.P.			
H.			
Tr.			
Dg.			
B.L.			
L.			
K.C.			
B.K.C.			
Ce.			
C.			
M.			
M.			
K.			
Mz.			
Mo.			
V.			
S.			
S.			
A			
R.			
P€.			
G.			
T.D.			

Loc. in Sec. C NW SE

Geol.

Contr. Co. tools

Pool Nurse Pool

DEC 7 '55

FIRST REPORT

Date Comm. 11-30-55

drlg. 2110

Co. Lse. No. Sec. T. R.

SCOUT TICKET DX-201

SEC.	TWP.	R.
13	31	13W

WELL NO.

1 Gress — FARM

COMPANY

Ed Adair

CONTRACTOR

CORRECTION


C W/2 NW SE

660 FT. FROM N. LINE

FT. FROM S. LINE

FT. FORM E. LINE

330 FT. FROM W. LINE

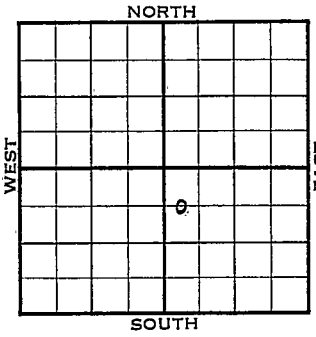

Barber County

☐ LOCATION

☐ RIG UP

DRILLING AND REMARKS:

Reported

C NW SE

RECORD

CASED IN., FT.

SAND

GAS

OIL

TOTAL DEPTH

PRODUCTION

1ST 24 HRS. NAT.

1ST 24 HRS. AFTER SHOT

GAS CU. FT.

DRY HOLE

ABANDONED

DATE	SCOUT
DEC 21 1955	

FORM 513 REV. SUNRAY

County Barber Elev. 1578 Co.

Sec. 13 Twp. 31 Rge. 13W

Company Ed Adair

Farm Name Gress No. 1

TOPS	DEPTH	LOG	DATUM
Anh.			
T.P.			
H.			
Tr.			
Dg. sd	3548		1970
B.L.			
L.	3671		2093
K.C.			
B.K.C.			
Ce.			
C.			
M.	4159		2581
M.			
K.			
Mz.			
Mq.			
V.			
S.			
S.			
A			
R.			
P€.			
G.			
T.D.	4190		

Loc. in Sec. C W½ NW SE

Geol.

Contr. Co. tools Lse.

Pool Nurse

ABANDONED

DEC 21 1955

No.

Date Comm. 11-30-55 Sec.

8 5/8" @ 166/135 DST 3529-45 open 1 hr rec. 5' mud DST 3545-70 open 1 hr. rec. 1500' gassy sw 1340/20" DST 3890-3 902 open 1 hr. rec. 60' o & gcm 30' wm 30' sw 1100/20" DST 3992-4002 open 1 hr. rec. 1880' GIP 180'gcsw 120' gassy sw 1380/20" DST 4120-59 open 1 hr. gas to surface in 40 min. T. R.

rec. 4085' GIP rec. 85' so & gcm
420/20"

D & A

R. G.

JAN 4 1956