


Section 17 Township 21 Range 13W

Well No. #3 G. Grow

Company Stanolind Oil and Gas Company

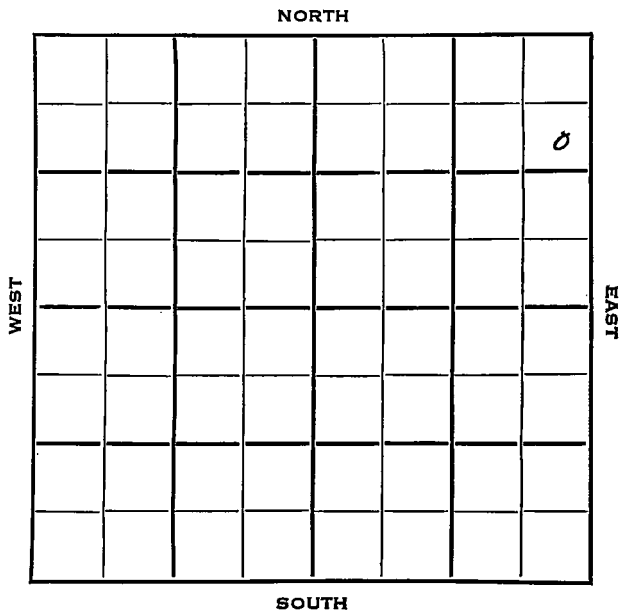

Sec. 17 Twp. 21 R. 13W

Well No. #3 G. Grow Farm

Stanolind Company

Contractor


990 Ft. from N. Line

Ft. from S. Line

330 Ft. from E. Line

Ft. from W. Line

SE NE NE

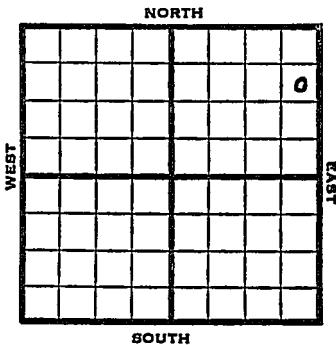

1953 Elev. 1898' REPORT

2/4 Location
 2/12 8" @ 795
 Drlg. 3155
 2/19 Drlg.
 2/26 "
 3/4 Spud 2-2-53
 D&A
 TD 3709
 8" @ 795
 Lans 3358
 DST 3433-51, opn 1 hr., rec.
 425' sw, 1095#
 DST-3480-3504, opn 1 hr., rec.
 4' mud, 0#
 DST 3580-95, opn 1 hr., rec.
 90' sw, 1130#
 DST 3660-65, opn 1 hr., rec.
 5' mud 0#
 Arb 3693
 DST 3693-97, opn 1 hr., rec.
 5' oil, 180' ocm, 600#
 TD 3700
 5" @ 3696
 CO to 3700
 18 goph 9 gw 500A 20 go 10 gw
 ph 3 hrs., 1000A 28 go 30% wtr
 500A 35 go 35% wtr 2000A

OVER

#3 G. Grow

(Information Brought Forward)

1953

3/4

5 bwph & SSO DD 3709

PB 3625

12/3594-9B, S/5 bwph

PB 3555 20/3539-43, 1000A

PB 3533

12/3521-25, 500A

PB 3512 24/3488-92, 500A

D&A

ABANDONED

County Stafford State Kansas

Sec. 17 (Blk. 21) (Sur. 13W) Map No.

Operator Stanolind

Well No. 3 Farm G. Grow

Elev. 1898 Location SE NE NE

990 Ft. From N Line NE
330 Ft. From E Line Quarter

Ist. Report

Completion MAR 4 1953

Remarks

Spudding Date 2-2-53

Drlg. Data D & A TD 3709

8" @ 795 Lans. 3358 DST 3433-51

open 1 hr. Rec. 425' sw 1095#

DST 3480-3504 open 1 hr. Rec. 4' mud

0# DST 3580-95 open 1 hr. Rec. 90' sw

1130# DST 3660-65 open 1 hr. Rec.

5' mud 0# DST 3693 DST 3693-97

open 1 hr. Rec. 5' oil 180' ocm 600#

TD 3700 5" @ 3696 CO to 3700

18 goph 9 gw 500 A 20 go 10 gwph

3 hr. 1000 A 28 go 30% wtr. 500 A

35 go 35% wtr. 2000 A 5 bwph & SSO

DD 3709 PB 3625 12/ 3594-98 S/ 5 bwph

PB 3555 20/ 3539-43 1000 A PB 3533

12/ 3521-25 500 A PB 3512

J. G. McGEHEE

Drig. Data

24/ 3488-92 500 A

D & A

Miss.	_____
Pierce Map	_____
France Map	_____
Tracings	_____
Land Wall Map	_____
Land Small Map	_____
Scout Cards	_____

110

3

MAR 1 1 1953