

KANSAS

Stafford

Section 32 Township 21 Range 13-WWell No. #4 ChapmanCompany Raymond Letow
Hufford

						0	

NORTH

WEST

EAST

SOUTH

Stafford

KANSAS

Sec. 32 Twp. 21 R. 13W

Well No. #4 Chapman Farm

Raymond Lebow Company

Hufford Pool Contractor


 Ft. from N. Line

330' Ft. from S. Line

990' Ft. from E. Line

 Ft. from W. Line

SW SE SE

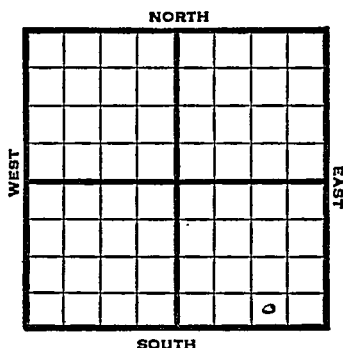

1950 Elv. 1903' REPORT

3/8 Cellar & Pits
4/26 TD 3768'
10"@ 321'
Anhy 790'
Heebner 3225'
Br Lime 3363'
Lans 3380'
DST 3541-51
Rec 15' mud
Viola 3654'
Arb. 3746'
5"@ 3768'
1500 A
Comp 1122 bopd
21% wtr.
Comp

COMPLETED

Kansas

Map No. _____ Sec. 32 Twp. 21 R. 13WWell No. 4 Chapman


_____ Raymond Lebow _____ Company

_____ Contractor

SW SE SE

E. 1. 1903

SECTION PLAT

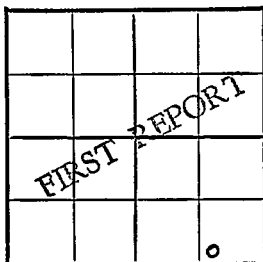

_____ Ft. from N. Line

330 Ft. from S. Line990 Ft. from E. Line

_____ Ft. from W. Line

Stafford County

Location _____

Rig up _____

Drilling and Remarks:

Cellar & pits ☒

RECORD

Cased _____ in., _____ ft.

Sand _____

Gas _____

Oil _____

Total Depth _____

PRODUCTION

1st 24 hrs. Nat. _____

1st 24 hrs. after shot _____

Gas _____ Cu. Ft.

Dry Hole _____

Abandoned _____

Date

MAR 8 1950J. E. TYRA Scout

Kansas


Hufford Pool

Map No. _____ Sec. 32 Twp. 21 R. 13WWell No. 4 ChapmanRaymond-Lebow

Company

Contractor

SW SE SE

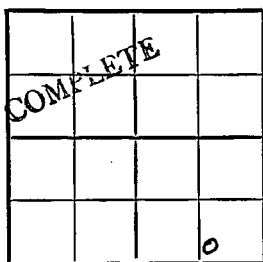E. 1903
SECTION PLAT

_____ Ft. from N. Line

330 Ft. from S. Line990 Ft. from E. Line

_____ Ft. from W. Line

Stafford County

Location _____

Rig up _____

Drilling and Remarks:

*10" C 321**anhy. 790**Hebner 3225**Br. line 3363**Lans. 3380**DST 3541-51**Rec. 15' mud*

RECORD

Cased _____ in. _____ ft.

Sand _____

Gas _____

Oil _____

Total Depth 3768

PRODUCTION

1st 24 hrs. Nat. _____

1st 24 hrs. after shot _____

Gas _____ Cu. Ft.

Dry Hole _____

Abandoned _____

Date

APR 26 1950 19J. E. TYRA

Scout

Viola 3654
arb. 3746
5" c 3768

1500 A

Comp. 1122 *lspd 21% water*

Scout Cards
Land Small Map
Land Wall Map
Tracings
France Map
Pierce Map
Misc.

5

MAY 3

RECORDS





