

Section 32 Township 21 Range 13 W

Well No. # 5 Chapman

Company Francis Raymond

NORTH

							0

WEST

EAST

SOUTH

Sec. 32

Twp. 21

R. 13W

Well No. #5 Chapman

Farm

Francis Raymond

Company

Contractor


990 Ft. from N. Line

Ft. from S. Line

330 Ft. from E. Line

Ft. from W. Line

SE NE SE

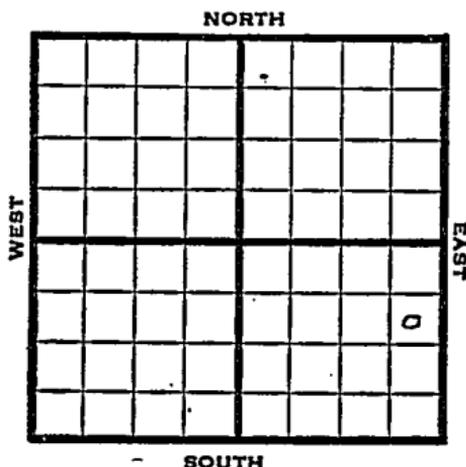

1952

Elev. 1903' REPORT

3/19

Spud 3-12-52

8" @ 301'

Anhy 766

Drlg. 2600'

3/25

Heeb 3233' Br Li 3361' Lans. 3373'

DST 3452-78, 1 hr, 780' gassy OCM

1005#

DST 3496-3512', 3/4 hr, 660' gas & MCO

DST 3516-50, 1 hr, 80' muddy oil, 590'

oil, 430' water, 910#

DST 3565-90-3/4 hr., 68' G & OCM

Drlg. 3594'

4/1

B KC 3596' Cong. 3622'

V 3644' Simp. 3694' ? Arb. 3757'

RTD 3760' 5" @ 3759'

MICT

4/9

DP DD to 3793 fill up wtr overnight to PB

4/23

PB 3711 36/3672-84 500 A

Fill up 900' oil 12 hrs. PB 3560

18/3524-30 18/3500-3506

12/3462-66 12/3449-53

6/3421-23 2000 A thru tub

OVER

1952

4/30 - Oil Well TD 3793 Spud 3-12-52
8" @ 301
Anhy 766 Heeb. 3233
Br Li 3361 Lans. 3373
DST 3452-78 open 1 hr. rec. 780'
gassy ocm
DST 3496-3512' open 45 min.
rec. 660' gas & mco
DST 3516-50 open 1 hr. rec. 80'
muddy oil 590' oil 430' wtr.
DST 3565-90 open 45 min. rec.
68' gas & ocm
B KC 3596 Cong. 3622
Viola 3644 Simp. 3694
Arb. 3757
TD 3760 5" @ 3759 DD 3793
FU wtr. overnite PB 3711
36/ 3672-84 500 A FU 900' oil
12 hr. PB 3560 18/ 3524-30
18/ 3500-3506 12/ 3462-66
12/ 3449-53 6/ 3421-23
2000 A PB 3516 18/ 3500-06
12/ 3462-66 12/ 3449-53
2000 A Comp. BHB 2821 bopd
2% wtr.

COMPLETED

Dirg. Data

18/ 3500-06 12/ 3462-66 12/ 3449-53
2000 A Comp. BHB 2821 bopd 2% water

MAY 6 1982

Misc.
Pierce Map
France Map
Tracings
Land Wall Map
Land Small Map
Scout Cards

[Handwritten signature]