
KANSAS Sedgwick

FORM 51 25M 3-49 PETROL

Section 31 Township 27 Range 4-W

Well No. #1 Davis

Company Westgate-Greenland

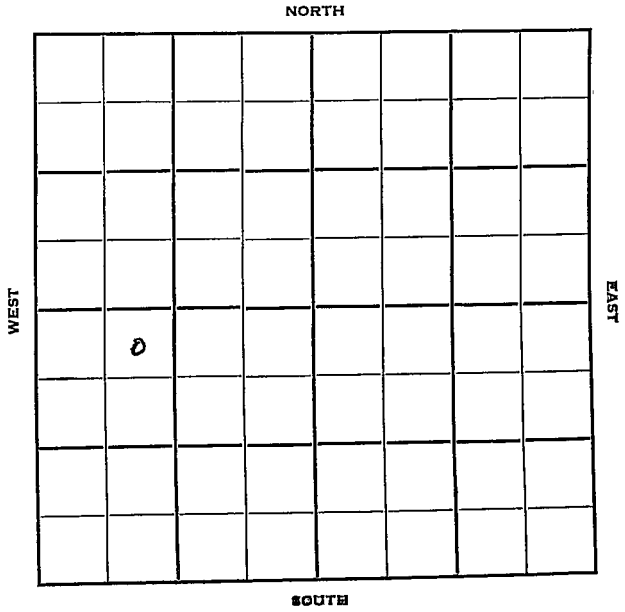

FORM 252-B
10M 9-49 PETROL

Sedgwick KANSAS

Sec. 31 Twp. 27 R. 4W

Well No. #1 Davis Farm

Westgate-Greenland Company

Contractor

Bartholomew


330' Ft. from N. Line

Ft. from S. Line

Ft. from E. Line

990' Ft. from W. Line

NE NW SW

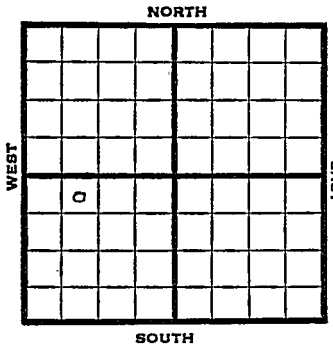

1950	Elev 1412' REPORT
2/22	Location
4/27	TD 3749' 10"@ 189' Br Lime 2847' Lans 2889' Miss 3701' SO 3744-49' DST 3736-49' Rec 1800' gas 120' O&GCM 25' free oil 5"@ 3736' DD 3749' 1000 A Flow 50 bo 1 hr 40 boph Comp 1118 bopd 3% wtr Comp COMPLETED

Form 26 200 Bks. 11-49 Petrol Kansas Bartholomew Pool

Map No. _____ Sec. 31 Twp. 27 R. 4W

Well No. 1 Davis

Westgate-Greenland Company

_____ Contractor

NE NW SW

330 Ft. from N. Line


_____ Ft. from S. Line

_____ Ft. from E. Line

990 Ft. from W. Line

Sedgwick County

SECTION PLAT

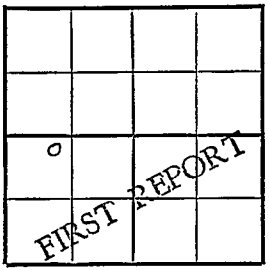

Location x

Rig up _____

Drilling and Remarks:

RECORD

Cased _____ in., _____ ft.

Sand _____

Gas _____

Oil _____

Total Depth _____

PRODUCTION

1st 24 hrs. Nat. _____

1st 24 hrs. after shot _____

Gas _____ Cu. Ft.

Dry Hole _____

Abandoned _____

Date

FEB 2 2 1950 19 J. E. TYRA Scout

Form 26 200 Bks. 11-49 Petrol

Kansas

Bartholomew Pool

Map No. ____ Sec. 31 Twp. 27 R. 4W

Well No. 1 Davis


Westgate-Greenland Company

Contractor

NE NW SW

El. 1412

SECTION PLAT

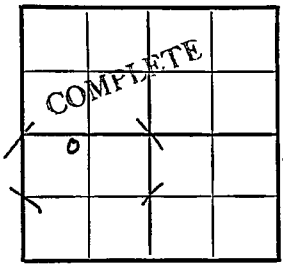

330 Ft. from N. Line

Ft. from S. Line

Ft. from E. Line

990 Ft. from W. Line

Sedgwick County

Location

Rig up

Drilling and Remarks:

10" @ 189
Br Lime 2847
Lans. 2889
Miss. 3701
TD 3744-49
DST 3736-49
Rec. 1850' gas

RECORD

Cased ____ in., ____ ft.

Sand

Gas

Oil

Total Depth 3749

PRODUCTION

1st 24 hrs. Nat.

1st 24 hrs. after shot

Gas ____ Cu. Ft.

Dry Hole

Abandoned

Date

APR 26 1950 19

J. E. TYRA. Scout

120' o+g c.m.
25" Detail
5" @ 3736

DD 3749
1000 A
Flow 50 b
" 40 b
Comp. 1118 Dept. 3 Towater

Scout Cards
Land Small Map
Land Wall Map 1
Tracings
France Map
Pierce Map
Misc.