


KANSAS

FORM 51 25M 3-49 PETROL

Section 22 Township 26 Range 33-W

Well No. #1 Warren

Company C S O

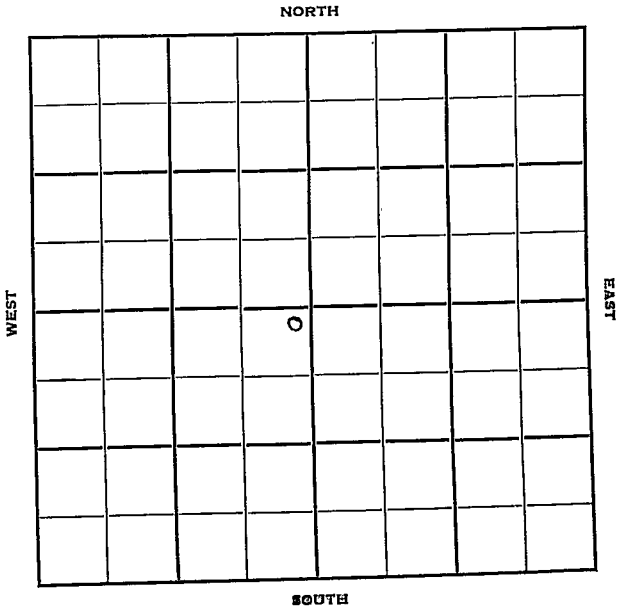

Finney
26

KANSAS

Sec. 22 Twp. R. 33W ✓

Well No. #1 Warren Farm

C S O

Company

Contractor


Ft. from N. Line

Ft. from S. Line

Ft. from E. Line

Ft. from W. Line

100 S & W of C

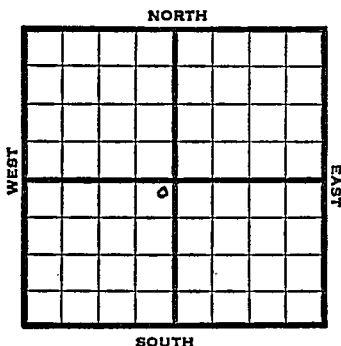

1950

Elev. 2933' REPORT

5/17

Spud 5-14-50
8" @ 805'

6/21

8" @ 805'
Her. 2584'
Krid-r 2616'
Win 2674'
Ft. Riley 2730'
TD 2785'
5" @ 2784'
TD 2785'
36/2686-98
18/2674-80
42/2642-56
60/2616-36
21,000 acid
Comp. 8,770,000 gas 413#
TD 2785'

COMPLETED

Map No. _____ Sec. 22 Twp. 26 R. 33WWell No. 1 WarrenC S O Company

Contractor

100 S & W of C


SECTION PLAT

_____ Ft. from N. Line

_____ Ft. from S. Line

_____ Ft. from E. Line

_____ Ft. from W. Line

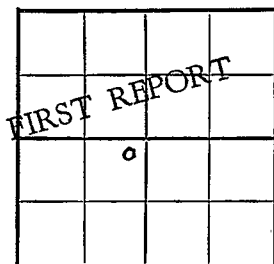

Finney

Location _____

Rig up _____

Drilling and Remarks:

Spud 5-14-50

8" @ 805'

RECORD

Cased _____ in., _____ ft.

Sand _____

Gas _____

Oil _____

Total Depth _____

PRODUCTION

1st 24 hrs. Nat. _____

1st 24 hrs. after shot _____

Gas _____ Cu. Ft.

Dry Hole _____

Abandoned _____

Date

MAY 17 1950 19

J. E. TYRA

Scout

Map No. _____ Sec. 22 Twp. 26 R. 33W

Well No. 1 Warren

Cities Service

Company

Contractor

NE SW

El. 2933


SECTION PLAT

100 Ft. from N. Line

_____ Ft. from S. Line

100 Ft. from E. Line

_____ Ft. from W. Line

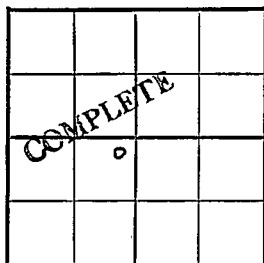

Finney County

Location _____

Rig up _____

Drilling and Remarks:

8" C 805

Her. 2584

Krider 2616

Win. 2674

Ft. Riley 2730

TD 2785

5" C 2784

RECORD

Cased _____ in., _____ ft.

Sand _____

Gas _____

Oil _____

Total Depth 2785

PRODUCTION

1st 24 hrs. Nat. _____

1st 24 hrs. after shot _____

Gas _____ Cu. Ft.

Dry Hole _____

Abandoned _____

Date

JUN 21 1950

19

J. E. TYRA

Scout

36/ 2686-98

18/ 2674-80

42/ 2642-56

60/ 2616-36

21000 acid

Comp. 8,770,000

1960 JUN 28 1960

Misc.






