


Marion

SECTION 28 TOWNSHIP 17 S RANGE 4 E

WELL NO. # 2 Bernhardt

COMPANY Bert Young et al

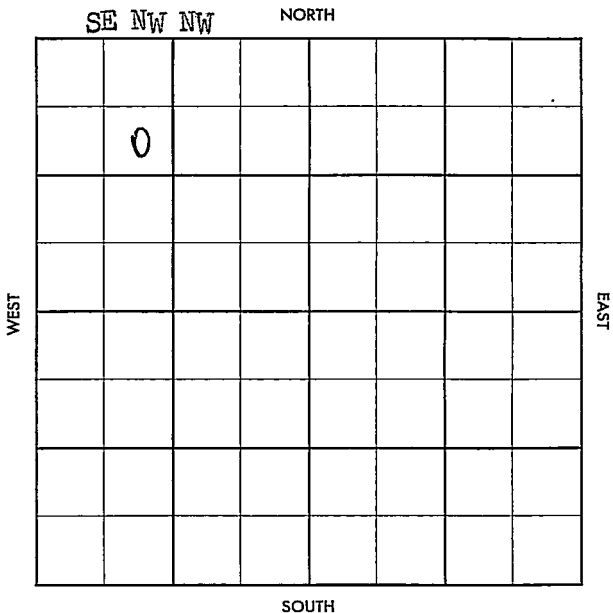

County Marion Elev. \_\_\_\_\_  
 Sec. 28 Twp. 17 Rgs. 4E  
 Company Bert Young, etal  
 Farm Name Bernhardt No. 2

Co.  
No.  
Sec.  
T.  
R.

TOPS	DEPTH	LOG	DATUM
Anh.			
Tr.			
H.			
Tr.			
Dg.			
Bl.			
L.			
K.C.			
B.K.C.			
Ce.			
C.			
M.	2385		
M.			
K.			
Mz.			
Me.			
V.			
S.			
S.			
A.			
R.			
PE.			
G.			
TD.			

Loc. in Sec. SE NW NW  
 Geol. \_\_\_\_\_  
 Contr. \_\_\_\_\_  
Sunflower Tobs  
 Pool \_\_\_\_\_  
Lost Springs

9  
**FIRST REPORT**  
 AUG 21 1957

Date Comm. 8-14-57  
10" @ 235, RTD 2394, 7" @ 2389

*[Handwritten scribbles and marks]*

County Marion Elev. 1487 DF  
 Sec. 28 Twp. 17 Rge. 4E  
 Company Bert Young, etal  
 Farm Name Bernhardt No. 2

TOPS	DEPTH	LOG	DATUM	Loc. in Sec.
Anh.				SE NW NW
Tp.				<u>Twin</u>
H.				
Tr.				
Dg.				
Bl.				
L.				Geol.
K.C.				Contr.
B.K.C.				Sunflower To
Ce.				Pool
C.				Lost Springs
M.	<u>2385</u>			
M.				
K.				
Mz.				
Me.				
V.				
S.				
S.				
A.				
R.				
Pe.				
G.				
T.D.				

SEP 25 1957  
 COMPLETE

Date Comm. 8-14-57  
10" @ 235, RTD 2394, 7" @ 2389 AUG 11 1957  
SEP 4 57 SEP 11 57 DD 2398  
Phas \$ Ld 20 Bopd  
35 Bwpd

Co.  
 No.  
 Sec.  
 T.  
 R.