


Section 16 Township 17 Range 4E

Well No. #1 Deines

Company D. G. Hamilton

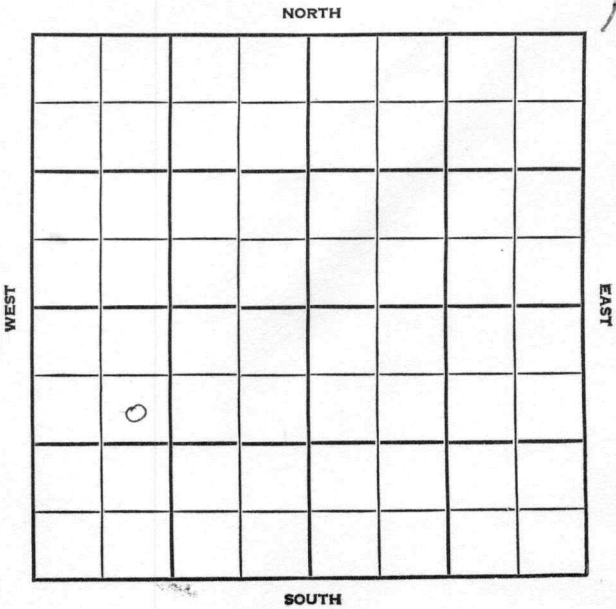

Marion

KANSAS

SEC. 16	TWP. 17	R. 4E
------------	------------	----------

WELL NO. #1 Deines FARM

COMPANY D. G. Hamilton

CONTRACTOR Ainsworth


Lost Springs

_____ FT. FROM N. LINE

_____ FT. FROM S. LINE

_____ FT. FROM E. LINE

_____ FT. FROM W. LINE

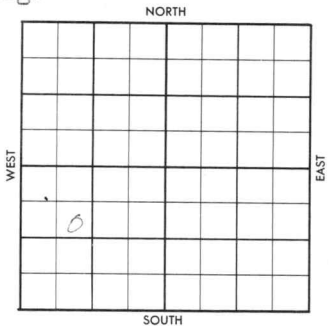


SE NW SW

1956	ELEVATION	REPORT
------	-----------	--------

8-1 Location

County Hamilton Elev. 1441
 Sec. 16 Twp. 17 Rge. 1E
 Company D. C. Hamilton
 Farm Name Deines No. 1

TOPS	DEPTH	LOG	DATUM	Loc. in Sec.
Anh.				SE NW SW
TP.				
H.				
Tr.				
Dg.				
BL.				
L.				
K.C.				Geol.
B.K.C.				Contr.
Ce.				
C.				Ainsworth
M. <u>chat</u>	<u>2371</u>			
M.				Pool
K.				Lost Springs
Mz.				
Ma.				
V.				
S.				
S.				
A.				
R.				
Pe.				
G.				
T.D.	<u>2372</u>			

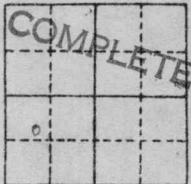

Date Comm. OCT 10 1956

Location AUG 8 '56 8-2-56 7" P31

376 AUG 15 '56 1497 AUG 22 '56

1800 AUG 29 '56 2330 SEP 5 '56

4 1/2 @ 2371 CO DD @ 2393 SEP 12 '56

no show P.B 2379 Frac SEP 19 '56

P. Ld. SEP 26 '56 P. Wt. OCT 3 '56 OCT 10 '56

P. 10 B0 + 70 Bwpd.