


Section 30 Township 21 Range 13 W

Well No. # 5 Brown

Company K & E Drlg.

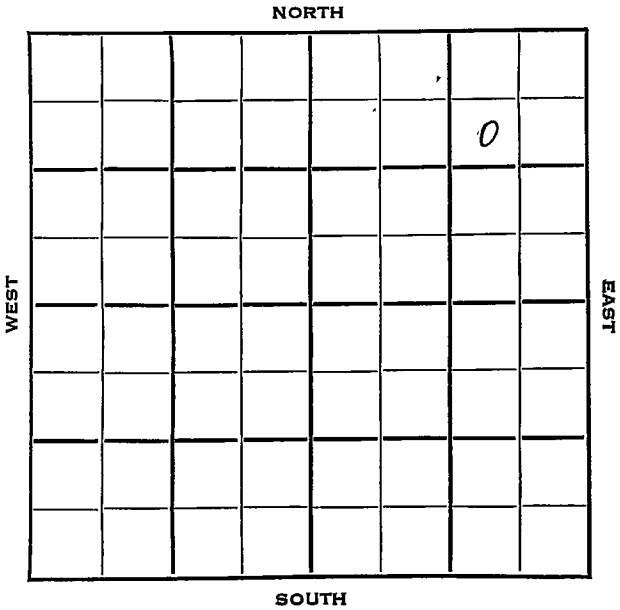

Stafford KANSAS

SEC.	TWP.	R.
30	21	13W ✓

WELL NO. **5 Brown** FARM

COMPANY

K & E Drlg.

CONTRACTOR


K & E Drlg.  
Pundsack Pool

990 Ft. from N. Line

Ft. from S. Line

990 Ft. from E. Line

Ft. from W. Line

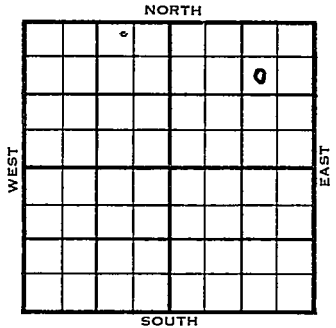

SW NE NE

1953	ELEVATION	REPORT
	1914'	

12/16 Spud 12-10-53  
10" @ 185'  
Anhy 190'  
Drlg. 2296'

1954  
2/17

Spud 12-10-53  
Oil Well  
TD 3729'  
10" @ 185'  
Anhy 190', Lans 3372'  
DST 3375-3420', opn 1 hr., rec. 3000' gas, 85' gcm, 500#  
DST 3444-81', opn 1 hr., rec. 30' o & gcm, 60' oil & mud, 120' oil, 930#  
DST # 3491-3503', opn 1 hr., rec. 60' ho & gcm, 180' gassy oil, 920#  
DST 3510-23', opn 1 hr., rec. 213' sw, 710#  
DST 3545-85', opn 1 hr., rec. 600' gas 170' mco, 1050#  
Viola 3628', Simp 3667', Arb. 3726'  
TD 3729'  
7" @ 3728'  
CO to 3705', 32/3578-86, S/1 boph

(Information Brought Forward)

1954  
2/17

12/3460-63, 12/3442-45, 1000A  
S/5 boph 32/3578-86, 24/3491-97,  
1000A  
S & F 29 bo 2 hrs.  
CO to 3705'  
Comp. 333 bopd

**COMPLETED**





Orig. Data

CO to 3705

Comp 333 hand

SCOUT CARDS
Land Small Map
Land Wall Map
Tracings
France Map
Pierce Map
MISC.

FEB 23 1954