


Section 29 Township 21 Range 13 W

Well No. # 5 Essmiller "B"

Company Cities Service

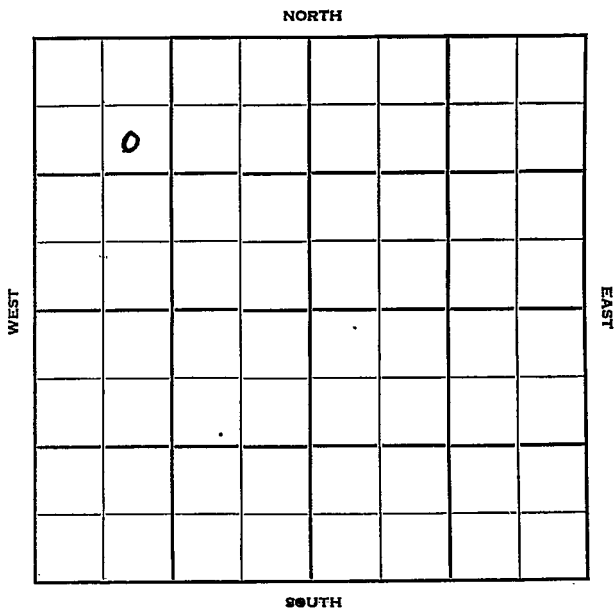

Sec. 29 Twp. 21 R. 13 W

Well No. # 5 Essmiller "B" Farm

Cities Service Company


Holm Contractor

990 Ft. from N. Line

Ft. from S. Line

Ft. from E. Line

990 Ft. from W. Line

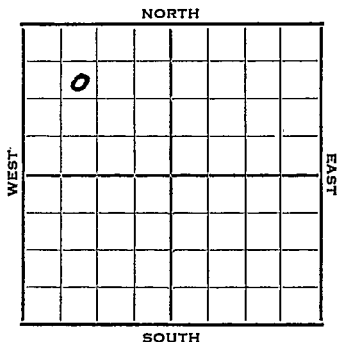

SE NW NW

1952

Elev. 1909' REPORT

7/23

Location

7/30

RUR

8/6

10" @ 366 Drlg. 3050

8/13

Lans. 3356

DST 3390-3406, 1 hr. gas in 65"

75' G&MCO 60' MCO 825# 30"

DST 3422-32, 1 hr. 200' Hly MCO

560' oil 1000# 15"

DST 3438-46, 1 hr. 240' GCO 120'

MCO 1075#

DST 3478-90, 1 hr. 420' Hly GCO

990# 15"

DST 3497-3507, 1 hr. 2045' oil

1170#

DST 3516-30, 1 hr. 55'm & VSSO Drlg.

8/20

DST 3534-52 1 hr. 175' G&MCO 1250#

BKG 3584 Cherty Cong 3606

V 3614 Simp 3656 Arb 3706

RTD 3707 Schl 7" @ 3707

8/27

CO 3683 51/ 3533-47 36/ 3496-3508

660' oil 1½ hr. FHO 13 hrs.

3000 A F 170 BO 5½ hrs.

9/3

NR

9/10

"

OVER

1952

9/17

Spud 7-29-52

Oil well TD 3707' 10" @ 366

Lans. 3356'

DST 3390-3406 open 1 hr, gas in 55
min, rec 75' G & MCO, 60' MCO 825#

DST 3422-32 open 1 hr, rec 200' HMCO
560' oil, 1000#

DST 3438-46 open 1 hr, rec 240' GCO
120' MCO 1075#

DST 3478-90 open 1 hr. rec 420' HGCO
990#

DST 3497-3507 open 1 hr. rec 2045' oil
1175#

DST 3516-30 open 1 hr. rec 55' mud &
VSSO, 75#

DST 3534-52 open 1 hr. rec 175' gas &
MCO, 1250# B KC 3584' Cong. 3606'

Viola 3614', Simp 3656' Arb. 3706'

TD 3707' 7" @ 3707' GO to 3683'

51/3533-47 36/3496-3508.

FU 660' oil 1½ hr. HFO 13 hr.

3000 A F/170 BO 5½ hr.

Comp. 2519 BOPD 1% wtr.

COMPLETED.

Drig. Data

FU 660' oil $1\frac{1}{2}$ hr. HFO 13 hr.

3000. A F/ 170 bo $5\frac{1}{2}$ hr.

Comp. 2519 bopd

1% wtr.

Misc
Tracing Map
HT Note Map
Tracings
1" Wall Map
Lead Small Map
Scout Cards

W. W.

SEP 24 1952