

Russell **KANSAS**

Sec. 35 Twp. 13 R. 14W

Well No. #2 Fritzier Farm

Stearns Drlg.


Russell Townsite (Stearns Drlg., Cont.) Company

330' Ft. from N. Line

_____ Ft. from S. Line

990' Ft. from E. Line

_____ Ft. from W. Line

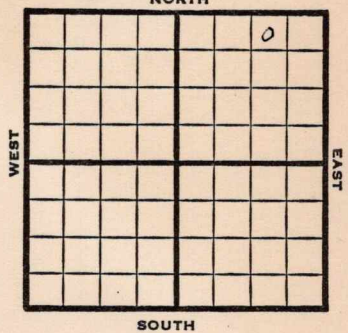

NW NE NE

1949 **Elev 1809'** REPORT

- 9/21 10" @ 207'
Anhy 817'
Drlg. 1470'
- 9/28 **Topeka 2684'**
Lansing 2971'
Drlg 3010'
- 10/5 **Arb. 3261-64'**
TD 3264'
7" @ 3261'
- 10/12 "
- 10/19 "
- 10/26 "
- 11/1 "
- 11/9 TD 3270'
Arb. 3261'
Aband.

ABANDONED

Map No. _____ Sec. 35 Twp. 13 R. 14W

Well No. 2 Fritzler

Stearns Drlg. _____ Company

Stearns Drlg. _____ Contractor

NW NE NE


FIRST REPORT
SECTION PLAT

330 Ft. from N. Line

_____ Ft. from S. Line

990 Ft. from E. Line

_____ Ft. from W. Line

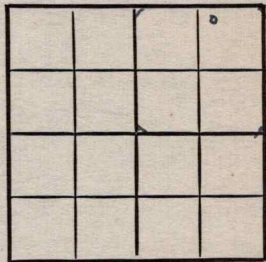

Russell County

Location _____

Rig up _____

Drilling and Remarks:

10" @ 207

Anhy 817

drlg. 1470

RECORD

Cased _____ in., _____ ft.

Sand _____

Gas _____

Oil _____

Total Depth _____

PRODUCTION

1st 24 hrs. Nat. _____

1st 24 hrs. after shot _____

Gas _____ Cu. Ft.

Dry Hole _____

Abandoned _____

Date

SEP 21 1949

19

S. J. LEWIS Scout

Kansas

14W

Map No. _____ Sec. 35 Twp. 13 R. _____

Well No. 2 Fritzler

Stearns Drlg. _____ Company

ABANDONED

Contractor

NW NE NE

E. 1809
SECTION PLAT

330 Ft. from N. Line

_____ Ft. from S. Line

990 Ft. from E. Line

_____ Ft. from W. Line

			0

Russell County

Location _____

Rig up _____

Drilling and Remarks:

Cor 83261

RECORD

Cased _____ in., _____ ft.

Sand _____

Gas _____

Oil _____

Total Depth 3270

PRODUCTION

1st 24 hrs. Nat. _____

1st 24 hrs. after shot _____

Gas _____ Cu. Ft.

Dry Hole _____

Abandoned _____

Date

NOV 9 1949

19

S. J. LEWIS

Scout