

DX 78-1

Harper


KANSAS

Section 23 Township 31 Range 6 W

Well No. # 1 Knowles

Company Texas Company

NORTH

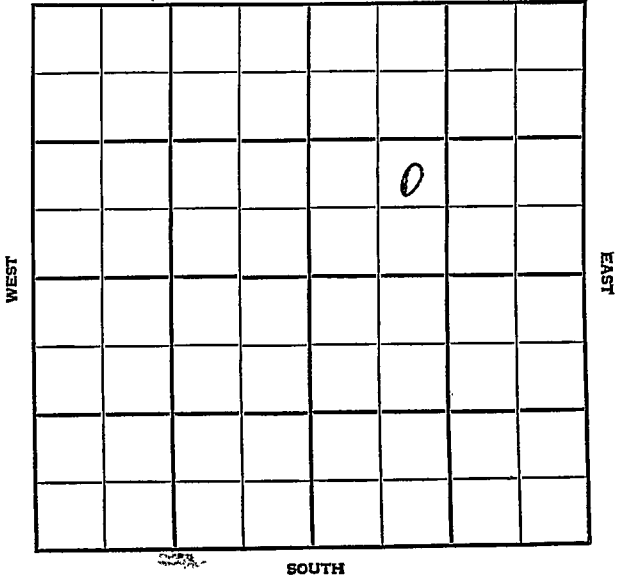

SEC.	TWP.	R.
23	31	6W

WELL NO.

#1 Knowles

FARM

COMPANY

Texas Company

CONTRACTOR

Stickle

Runnymede Pool NORTH

Ft. from N. Line

990


Ft. from S. Line

Ft. from E. Line

990

Ft. from W. Line

NE SW NE

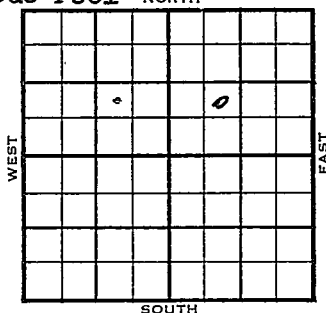

1955

ELEVATION
1403'

REPORT

1/5

Spud 12-30-54
10" @ 514'
Drlg. 2165'

2/16

Spud 12-30-54 SI Gas well TD 4719
10" @ 514 Severy sd 2606'

DST 2601-19 open 1 hr rec 15' mud
975# Hoover 2920' Top 2667'

Doug 3188', Stal. 3394'

DST 3390-3415, open 1 hr rec 995' SW
1410# KC 3648

DST 3666-85 open 1 hr rec 140' SO &
GCSW 1515#

DST 3754-77 open 1 hr rec 12' SOCM
134#

DST 3785-95 open 1 hr rec 180' gas,
95' O & GCSW 1596#. Cherokee 4084'
Miss. 4245'

DST 4250-75 open 1/2 hr gas in 8 min
75,000 CFG, 55' GCM 1670# Kh. 4554'
Chattanooga 4649', Simp. 4669'

DST 4662-74 open 20 min, gas in 75
seconds, 5,594,000 CFG rec 4' cond.
28' muddy brack wtr. 1900#

DST 4660-79 open 40 min, gas in 70
sec. 4,070,000 CFG in 5 min,
6,625,000 CFG in 40 mins, rec 28'
cond. 12' brack wtr. 1818#.

1955
2/16

(Information continued)

DST 4679-84 open 1 hr, rec 32'
drlg. mud. 15#.

DST 4684-94 open 1 hr rec 30' mud
34#.

DST 4694-4704, open 1 hr rec 45'
thin wtry salty drlg. mud 1800#.

TD 4719' 7" @ 4716 GO to 4660

36/4670-79 4,930,000 CFG.

Comp. SI gas well 4,930,000 CFGPD

COMPLETED



County Harper State Kansas

Sec. 23 (Blk. Twp.) 31 (Sur. Rge.) 6W Map No.

Operator Texas Company

Well No. 1 Farm Knowles

Elev. Location NE SW NE

		X	o		
FIRST REPORT					

990 Ft. From S Line NE

990 Ft. From W Line Quarter

Ist. Report JAN 5 1955

Completion

Remarks

Stickle - Contr.

Spudding Date 12-30-54

Drlg. Data Runnymede Pool

10" @ 514 drlg. 2165

Drlg. Data.

Rec. 4' cond. 28' muddy brack wtr. 1900#

DST 4660-79 open 40 min. gas in 70 sec.

4,070,000 cfg in 5 min. 6,625,000 cfg
in 40 min. Rec. 28' cond. 12' brack wtr.

1818# DST 4679-84 open 1 hr. Rec.

32' drlg. mud 15# DST 4684-94

open 1 hr. Rec. 30' mud 34# DST 4694-

4704 open 1 hr. Rec. 45' thin wtry salty

drlg. mud. 1800# TB 4719 7" @ 4716

CO to 4660 36/ 4670-79 4,930,000 cfg

Comp. SI gas well 4,930,000 cfg

FEB 21 1955

Scout Cards
 Land Small Map
 Land Well Map
 Trainers
 5