


Section 5 Township 30 Range 2 W

Well No. #1 Van Allen

Company Ted Ferrier

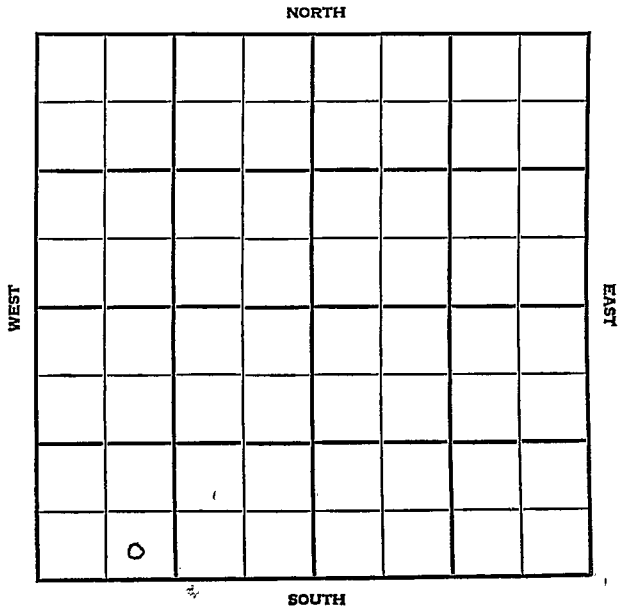

Sumner


KANSAS

SEC. 5	TWP. - 30	R. 2W
-----------	--------------	----------

WELL NO. #1 Van Allen FARM

COMPANY
CONTRACTOR Ted Ferrier

McKnab & Lindsey
Latta Ext.
_____ Ft. from N. Line
_____ Ft. from S. Line
_____ Ft. from E. Line
_____ Ft. from W. Line

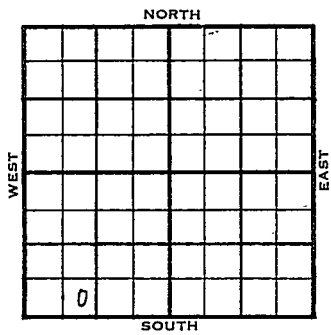

SE SW SW

	ELEVATION	REPORT
1956	1309	

2-29 RUR

4-18 Comm. 2-26-56
 8 5/8" @ 122
 DST 3139-51 op 1 hr. rec. 60' ocm, 60' msw, 1070/20"
 DST 3172-84 op 1 hr. rec. 60' gocm, 210' gassy oil, 45' msw, 990#
 DST 3647-61 op 1 hr. gas in 18 min. rec. 90' mcw, 700#
 DST 4057-65 op 2 hrs. 200' GIP rec. 40' socm, 50' sw, 1500/20"
 5 1/2" @ 3268
 CO to 3180, 24/ 3172-76
 S/ mud, oil & wtr., 500 A
 S/ 20 boph, 8 hrs.,
 P/ 25 bopd,
 Comp. 116 bopd, 3% wtr.
 Tp. 1954
 H. 2386
 KC 3014
 BKC 3213
 M. 3627
 S. 4053
 TD 4169'

COMPLETED

County Sumner Elev. _____
 Sec. 5 Twp. 30 Rge. 2W
 Company Ted Verrier
 Farm Name Van Allen No. 1

TOPS	DEPTH	LOG	DATUM	Loc. in Sec.
Anh.				SE SW SW
Tp.				
H.				
Tr.				
Dg.				
Bl.				
L.				Geol. _____
K.C.				Contr. _____
B.K.C.				<u>McKnab & Linds</u>
Ce.				
C.				Pool _____
M.				<u>Latta Ext.</u>
M.				
K.				
Mz.				
Ma.				
V.				
S.				
S.				
A				
R.				
PE.				
G.				
FD.				

FIRST REPORT
 FEB 29 '56

Date Comm.
RUR

(Handwritten signature/initials)

Co.
 No.
 Sec.
 T.
 R.

County Sumner Elev. 1309
 Sec. 5 Twp. 30 Rgs. 2W
 Company Red Ferrier
 FarmName Van Allen No. 1

TOPS	DEPTH	LOG	DATUM
Anh.			
TP.	<u>1954</u>		
H.	<u>2386</u>		
Tr.			
Dg.			
BL.			
L.			
K.C.	<u>3014</u>		<u>1705</u>
B.K.C.	<u>3213</u>		<u>1904</u>
Ce.			
C.			
M.	<u>3627</u>		<u>2318</u>
M.			
K.			
Mz.			
Me.			
V.			
S.	<u>4053</u>		<u>2744</u>
S.			
A.			
R.			
PE.			
G.			
T.D.	<u>4169</u>		

Loc. in Sec.

SE SW SW

Geol.

Contr.

McKnab & Lind

Pool

Latta Ext.

COMPLETE

Date Comm. 2-26-56

APR 18 1956

8 5/8" @ 122/ DST 3139-51 open 1 hr.

rec. 60' ocm 60' msw 1070/20"

DST 3172-84 open 1 hr. rec. 60' gocm

210' gassy oil 45' msw 990#

DST 3647-61 open 1 hr. gas in 18 min.

rec. 90' mcw 700# DST 4057-65

open 2 hr. 200' GIP - rec. 40' socm

50' sw 1500/20" 5 1/8" @ 3268

OVER

CO to 3180 2 1/2 / 3172-76 S/ mud, oil & wtr.
500 A S/ 20 boph 8 hr. P/ 25 bopd
Comp. 116 bopd 3% wtr.

R. G.

APR 26 1956