
Kingman KANSAS

SECTION 3. TOWNSHIP 30 RANGE 8 W

WELL NO. #1 Berthold

COMPANY Peckrell Drlg.

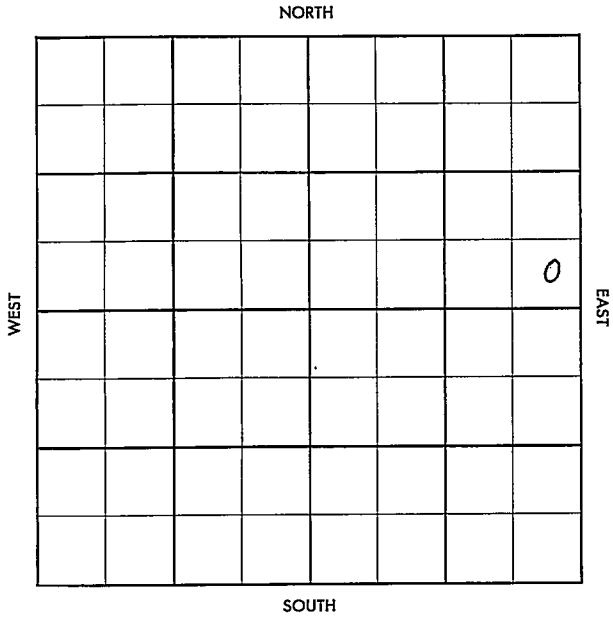

FORM 504-3 SUNRAY

Kingman KANSAS

SEC.	TWP.	R.
3	30	8 W

WELL NO. # 1 Bertholf FARM

COMPANY Pickrell Drlg.

CONTRACTOR Co. tools


Wildcat

_____ Ft. from N. Line

_____ Ft. from S. Line

_____ Ft. from E. Line

_____ Ft. from W. Line

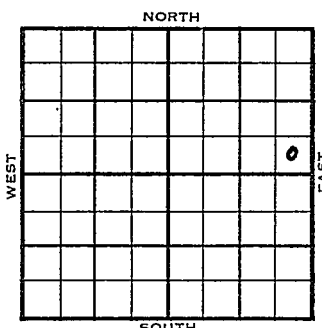

SE SE NE

Sohio AC - Gulf & Monsanto-DHM

SDX - 1 Mile

ELEVATION 1539'

1955	REPORT
11/16	Comm. 11-12-55 8" @ 120/125 Drlg. 1880'
11-25	Lans. 3427, Miss. 4153 DST 4157-80, op 1½ hr., gas in 2 min.
12-1	Kh. 4430, Viola 4544 Simp. sd. 4588 2540 mcfg in 15 min., 2750 mcfg in 30 min. , rec. 90' gcm, 30' msw, 1540# DST 4182-4205, gas in 3 min., 1100 mcfg in 30 min., rec. 90' gcm, 60' o&gcm, 60' ho&gcm, 45' muddy oil, 15' msw, 1540# DST 4206-50, op 1½ hr. rec. 2850' gas, rec. 120' so&gcm, 780# Drlg. 4615'
12-8	5½" @ 4716/150 CO to 4700 SP 4250, 48/ 4201-10 B/ 6 go, 12 gmwph 10 hrs., frac
12-15	5½" @ 4714, 3½ mcfgpd
12-22	Waiting on open flow test
12-29	Waiting on state test
1956 1-5	Comp. open flow 11 mcfgpd, COMPLETED Shutin gas well, TD 4732 A. 4702-4706

DX-78

FORM 513 REV. SUNRAY

County Kingman Elev.

Sec. 3 Twp. 30 Rge. 8W

Company Pickrell Drlg.

Farm Name Bertholf No. 1

TOPS	DEPTH	LOG	DATUM
Anh.			
T.P.			
H.			
Tr.			
Dg.			
B.L.			
L.			
K.C.			
B.K.C.			
Ce.			
C.			
M.			
M.			
K.			
Mz.			
Mg.			
V.			
S.			
S.			
A			
R.			
P€.			
G.			
T.D.			

Loc. in Sec. SE SE NE

Geol.

Contr. Co. tools

Pool Wildcat

FIRST REPORT NOV 16 1955

1 Mile

Date Comm. 11-12-55 Sohio AC Gulf & Monsanto - DHM

8" @ 120/125 --drlg. 1880

Co. Lse. No. Sec. T. R.

FORM 513 REV. SUNRAY

County Kingman Elev. 1539

Sec. 3 Twp. 30 Rge. 8W

Company Pickrell Drlg.

Farm Name Bertholf No. 1


TOPS	DEPTH	LOG	DATUM
Anh.			
T.P.			
H.			
Tr.			
Dg.			
Bl.			
L.	3427		1888
K.C.			
B.K.C.			
Ce.			
C.			
M.	4153	4155	2614
M.			
K.	4430	4430	2891
Mz.			
Mo.			
V.	4544	4544	3005
S.	4588	4590	3051
S.			
A	4702	4706	3167
R.			
P€.			
G.			
T.D.	4732		

Loc. in Sec. SE SE NE

Geol.

Contr. Co. tools

Pool Bertholf

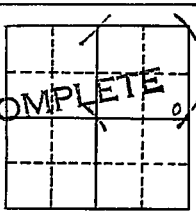

Date Comm. 11-12-55 JAN 5 1956

8" @ 120/125 DST 4157-80 open 1½ hr. gas in 2 min. 2,540 mcfg in 15 min. 2,750 mcfg in 30 min. rec. 90' gcm 30' msw 1540# DST 4182-4205 gas in 3 min., 1,100 mcfg in 30 min. rec. 90' gcm 60'-o & gcm 60' ho & gcm 45' muddy oil 15' msw 1540# DST 4206-50 open 1½ hr. rec. 2850' gas

Co. Lse. No. Sec. T. R.

120' so & gcm 780# 5½" @ 4716/150
CO to 4700 SP 4250 48/ 4201-10
B/ 6 go 12 gmwph 10 hr. frac
5½" @ 4714 Comp. open flow 11 mcfgpd
Shut in gas well

R. G.

JAN 13 1956