

Section 28 Township 21 Range 13W

Well No. #6 Hufford (A)

Company Petroleum Inc.

NORTH

WEST

EAST

	0						

SOUTH

C. W. P. B. Stafford

KANSAS

Sec. 28 Twp. 21 R. 13W

Well No. #6 Hufford (A) Farm

Petroleum, Inc. Company

Garvie
~~Gove~~ - Contr. Contractor


Ft. from N. Line

990' Ft. from S. Line

Ft. from E. Line

990' Ft. from W. Line

NE SW NW

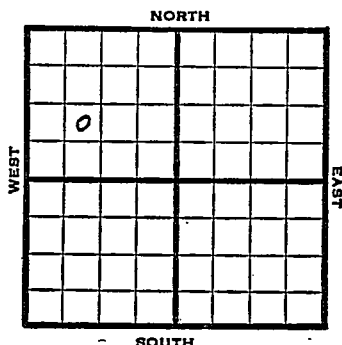

1952	Elev. 1904'	REPORT
5/21	MI	
5/28	8" @ 204'	
	Anhy 758	
	Drlg. 3055'	
6/11	RTD 3737'	5" @ 3729 CO. 3739
	250 A	10 gal oph & 8 gal wph
	500 A	S/ 100 Bopd & 50 Bwph
6/18	NR	
6/25	Sq. off B/ 3 Bfph	50% wtr. 1000 A
	21 Boph & 3 Bwph	POP
7/2	Spud 5-22-52	
	Oil well TD 3737'	8" @ 204
	Anhy 758'	Heeb 3212' Br. lime 3340'
	Lans. 3352'	
	DST 3360-88	open 1 hr. rec 1080' gassy & muddy oil.
	DST 3394-3402	open 1 hr. rec 70' 0 & GCM, 80' water.
	DST 3406-31	open 1 hr. rec 540' oil, 60' OCM
	DST 3436-3449'	open 1 hr. rec 30' SOCM
	60' HOCM,	120' muddy oil, 540' gassy oil, 300' wtr.
	DST 3530-62	open 1 hr. rec 180' gas, 30' OCM
	Cong. 3605'	Viola 3612' Simp. 3663'
	Arb. 3727'	
	DST 3728-31	open 1 hr. rec 25' mud

OVER

1952

7/2

(Information continued)

TD 3737' 5" @ 3729'

CO to 3737' 250 A 10 GPH

8 GPH 500 A S/100 BOPD 50 BW

1000 A 21 BOPH 3 BW

Comp. 100 BOPD 20% water.

COMPLETED

O. W. P. B.

1953

10/21

Oil Well

TD 3737'

KC 3352'

Viola 3612'

Simp 3663'

Arb. 3727'

OTD 3737

5" @ 3729'

PB 3449

6/3380-84

3/3370-73, 16/3380-84

$\frac{1}{2}$ BOPH 500 A

S/10 boph 3000A

S/14-17 boph

Comp. 778 bopd

FIRST REPORT

+


COMPLETED

County Stafford State Kansas
 Sec. 28 (Blk. Twp.) 21 (Sur. Rge.) 13W Map No.

Operator Petroleum Inc.

Well No. 6 Farm Hufford (A)

Elev. _____ Location NE SW NW

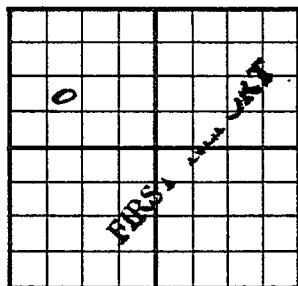

990 Ft. From S Line NW

990 Ft. From N Line Quarter

1st. Report MAY 21 1952

Completion _____

Remarks _____

Cove - Contr.

Spudding Date _____

Drlg. Data _____

MT


J. G. McGEHEE

County Stafford State Kansas
 Sec. 28 (Blk. 21) (Sur. 13W) Map No.

Operator Petroleum Inc.

Well No. 6 Farm Hufford "A"

Elev. 1904 Location NE SW NW

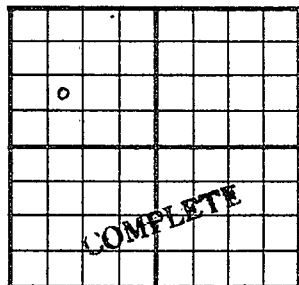

990 Ft. From S Line NW

990 Ft. From W Line Quarter

1st. Report

Completion JUL 2 1952

Remarks

Garvie - Contr.

Spudding Date 5-22-52

Drlg. Data Oil well TD 3737

8" @ 204 Anhy 758 Heeb. 3212

Br. lime 3340 Lans. 3352 DST 3360-88

open 1 hr. Rec. 1080' gassy & muddy oil

DST 3394-3402 open 1 hr. Rec. 70' o &

gcm 80' water DST 3406-31 open 1 hr.

Rec. 540' oil 60' ocm DST 3436-3449

open 1 hr. Rec. 2160' sw DST 3484-3523

open 1 hr. Rec. 30' socm 60' hocom

120' muddy oil 540' gassy oil 300' wtr.

DST 3530-62 open 1 hr. Rec. 180' gas

30' ocm Cong. 3605 Viola 3612

Simp. 3663 Arb. 3727 DST 3728-31

open 1 hr. Rec. 25' mud TD 3737

J. G. McGEHEE

Drlg. Data

5" @ 3729 CO to 3737 250 A 10 goph

8 gwph 500 A S/ 100 bopd, 50 bw

1000 A 21 boph 3 bw

Comp. 100 bopd ~~20%~~ water

7961 6 700

20% water

J. G. McGEHEE