


FORM 51 25M 3-49 PETROL

Section 7 Township 21 Range 13-W

Well No. #1 Brown (B)

Company Petroleum Inc.

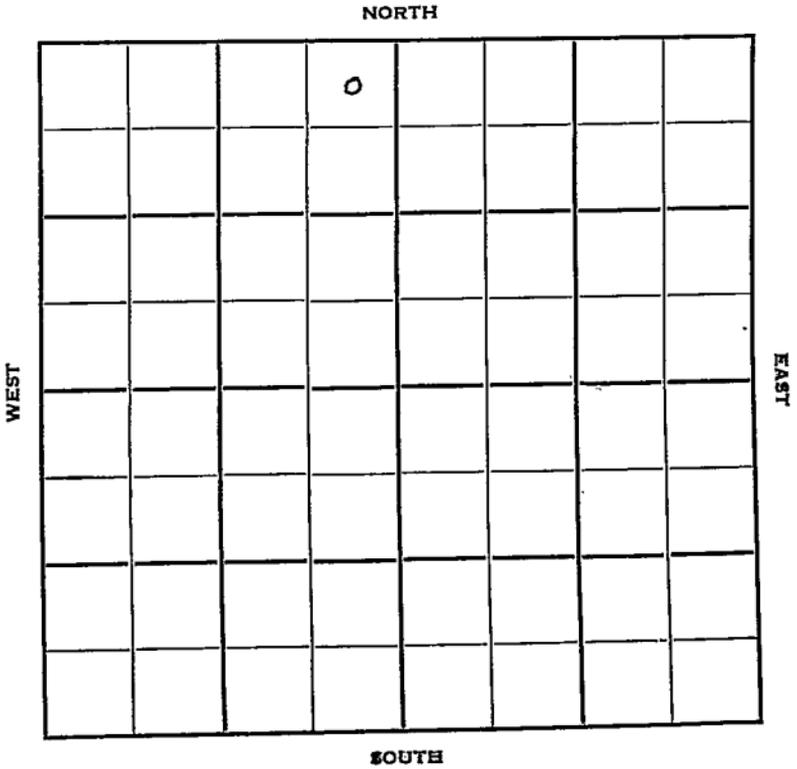

Sec. 7 Twp. 21 R. 13W

Well No. #1 Brown (Bⁱ) Farm _____

Petroleum, Inc. Company _____


Contractor _____

330' Ft. from N. Line

_____ Ft. from S. Line

330' Ft. from E. Line

_____ Ft. from W. Line
NE NE NW

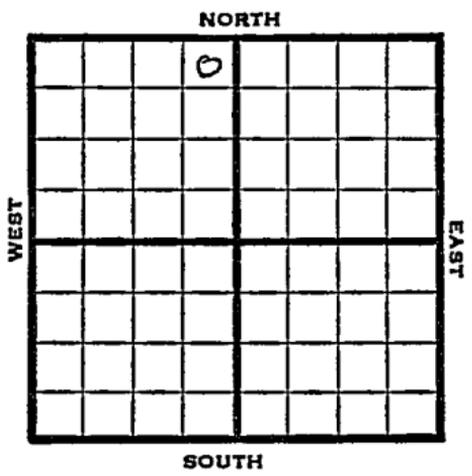

1950 Elev 1913 REPORT

5/31 Rig up
 7/12 8 5/8" @ 235
 Anhy 805-25 Br lime 3316
 Lans 3329
 DST 3446-61 opn 1 hr, rec 1500' oil
 Cong 3542 Viola 3550
 Simp 3583 Arb 3632
 5" @ 3633
 TD 3654
 24/3633-39
 250 acid
 PB 3500
 56/3446-59
 24/3446-59
 S/6-8 boph
 6000 acid
 S/20 boph
 5000 acid
 S/22 boph
 Comp 1119 bopd 22% wtr
 Completed

COMPLETED

Map No. _____ Sec. 7 Twp. 21 R. 13 W

Well No. 1 Brown (B)

Petroleum Inc. _____ Company

_____ Contractor

NE NE NW

330 Ft. from N. Line

_____ Ft. from S. Line

330 Ft. from E. Line

_____ Ft. from W. Line

SECTION PLAT

		o	
FIRST REPORT			

Stafford

Derby DHM StanodHM

Location _____

Rig up X

Drilling and Remarks:

RECORD

Cased _____ in., _____ ft.

Sand _____

Gas _____

Oil _____

Total Depth _____

PRODUCTION

1st 24 hrs. Nat. _____

1st 24 hrs. after shot _____

Gas _____ Cu. Ft.

Dry Hole _____

Abandoned _____

Date

MAY 31 1950

19

J. E. TYRA Scout

Map No. _____ Sec. 7 Twp. 21 R. 13WWell No. 1 Brown "B"

_____ Petroleum Inc. _____ Company

_____ Contractor

NE NE NW


E1. 1913
SECTION PLAT330 Ft. from N. Line

_____ Ft. from S. Line

330 Ft. from E. Line

_____ Ft. from W. Line

Stafford County

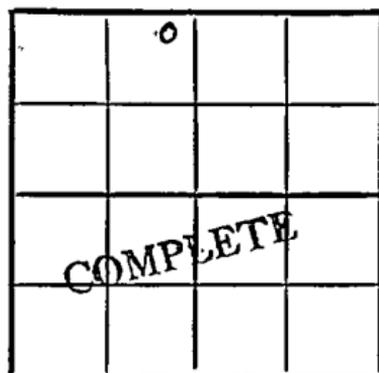

Location _____

Rig up _____

Drilling and Remarks:

8 5/8" C 235

Anhy 805-25

Br. lime 3316

Lans. 3329

DST 3446-61

open 1 hr.

RECORD

Cased _____ in., _____ ft.

Sand _____

Gas _____

Oil _____

Total Depth 3654

PRODUCTION

1st 24 hrs. Nat. _____

1st 24 hrs. after shot _____

Gas _____ Cu. Ft.

Dry Hole _____

Abandoned _____

Date

JUL 12 1950

19

I. E. TYRA Scout

Rec. 1500' oil

Cong. 3542

Viola 3550

Simp. 3583

Arb. 3632

5" 3633

TD 3654

24/ 3633-39

250 acid

PB 3500

56/ 3446-59

24/ 3446-59

S/ 6-8 boph

6000 acid

S/ 20 boph

5000 acid

S/ 22 boph

Comp. 1119 bopd 22% water

JUL 21 1950

Scout Cards
Land Small Map
Land Wall Map
Tracings
France Map
Pierce Map
Misc.

SEP 1 1950