
FORM 51 25M 8-50 WESTERN Stafford KANSAS

Section 7 Township 21 Range 13 W

Well No. # 2 Witt "C"

Company Petroleum Inc.

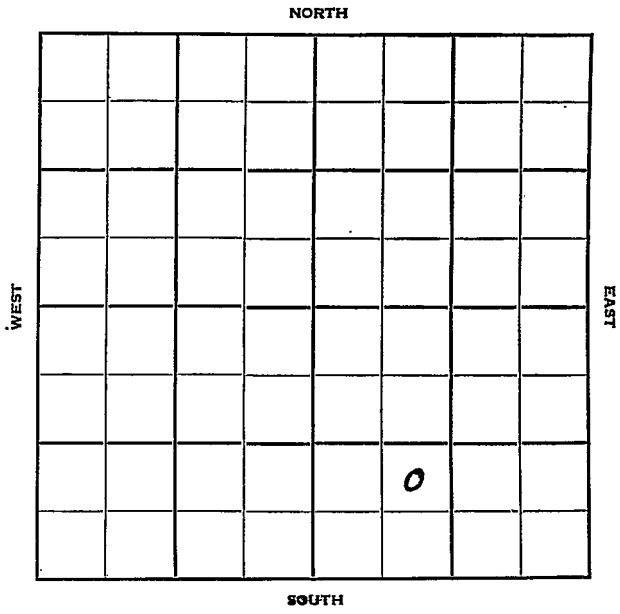

FORM 252-B
10M 8-51 TPCO.

KANSAS

Stafford

Sec. 7 Twp. 21 R. 13W

Well No. #2 Witt "E" Farm

Petroleum Inc. Company

Garvey Contractor

Dell Pool


Ft. from N. Line

990 Ft. from S. Line

Ft. from E. Line

990 Ft. from W. Line

NE SW SE

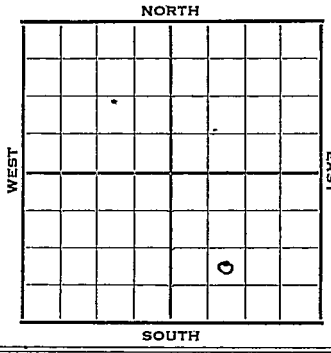

1952	Elev. 1911 REPORT
6/11	Spud 6-3-52 8" @ 221' Anhy 768' Drlg. 3160'
6/18	Heeb 3201' Br li 3320' Lans. 3330' Simp. 3581' Arb. 3636' RTD 3640' 5" @ 3637'
6/25	DP 3640 1 Boph & 15 gal wph PB 3521 Perf 3490-98 12 to 15 Boph
7/2	2000 A S/4 BOPH PB 3475 24/3456-64 1000 A S/4 BOPH plus 15% wtr. tubing & rods.
7/9	NR
7/17	NR
7/23	"
7/30	Spud 6-3-52 Oil Well TD 3640 8" @ 221 Anhy 768 Heeb. 3201 Br Li 3320 Lans. 3330 DST 3345-3405 open 1 hr. rec. 30' SW 1100# DST 3448-64 open 1 hr. rec. 120' HOCM 350# DST 3470-84 open 40 min. rec. 10' SOCM 30# DST 3485-3502 open 1 hr. rec. 45' HOCM 240' gassy oil, 650#

OVER

1952

7/30 Simp. 3581
DST 3542-87 open 40 min. rec. 12' mud
90# Arb. 3636
DST 3637-40 open 1 hr. rec. 45'
hocm 105' muddy oil 950#
TD 3640 5" @ 3637 DP to 3640
1 boph 15 gwph PB 3521
Perf/ 3490-98 12 to 15 boph
2000 A S/ 4 boph PB 3475
24/ 3456-64 1000 A S/ 4 boph
15% wtr.
Comp. 68 bopd 4% wtr.

COMPLETED

FORM 275 FOR SALE BY KANSAS BLUE PRINT CO


County Stafford State KANSAS

Sec. 7 (Blk. / Twp.) 21 (Sur. / Rge.) 13W Map No.

Operator Petroleum Inc.

Well No. 2 Farm Witt "C"

Elev. 1911 Location NE SW SE

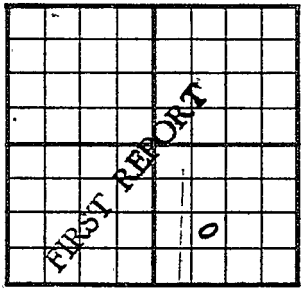

990 Ft. From S Line SE

990 Ft. From W Line Quarter

1st. Report JUN 11 1952

Completion

Remarks Garvey - Contr.

Spudding Date 6-3-52

Drlg. Data Dell Pool

8" @ 221 Anhy 768 drlg. 3160

J. G. McGEHEE

FORM 275 FOR SALE BY KANSAS BLUE PRINT CO.


County Stafford State Kansas

Sec. 7 (Blk. Twp.) 21 (Sur. Rge.) 13W Map No.

Operator Petroleum Inc.

Well No. 2 Farm Witt "C"

Elev. 1911 Location NE SW SE

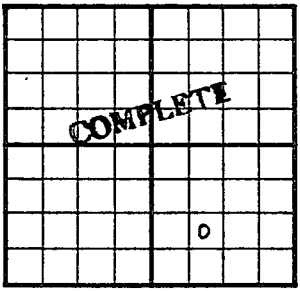

990 Ft. From S Line SE

990 Ft. From W Line Quarter

1st. Report

Completion JUL 3 0 1952

Remarks Dell Pool

Garvey - Contr.

Spudding Date 6-3-52

Drlg. Data Oil well TD 3640

8" @ 221 Anhy 768 Heeb. 3201

Br. lime 3320 Lans. 3330 DST 3345-3405

open 1 hr. Rec. 30' sw 1100# DST 3448-

64 open 1 hr. Rec. 120' hocm 350#

DST 3470-84 open 40 min. Rec. 10' socm

30# DST 3485-3502 open 1 hr. Rec.

45' hocm 240' gassy oil 650# Simp. 358

DST 3542-87 open 40 min. Rec. 12' mud

90# Arb. 3636 DST 3637-40 open 1 hr.

Rec. 45' hocm 105' muddy oil 950#

TD 3640 5" @ 3637 DP to 3640

1 boph 15 gwph PB 3521 Perf/ 3490-98

12 to 15 boph 2000 A S/ 4 boph

J. G. McGEHEE

Drlg. Data

PB 3475 24/ 3456-64 1000 A S/ 4 boph

15% water

Comp. 68 bopd 4% water

