
FORM 51 25M 8-50 WESTERN Stafford KANSAS

Section 8 Township 21 Range 13W

Well No. #1 Fischer

Company Petroleum Inc. & Omego

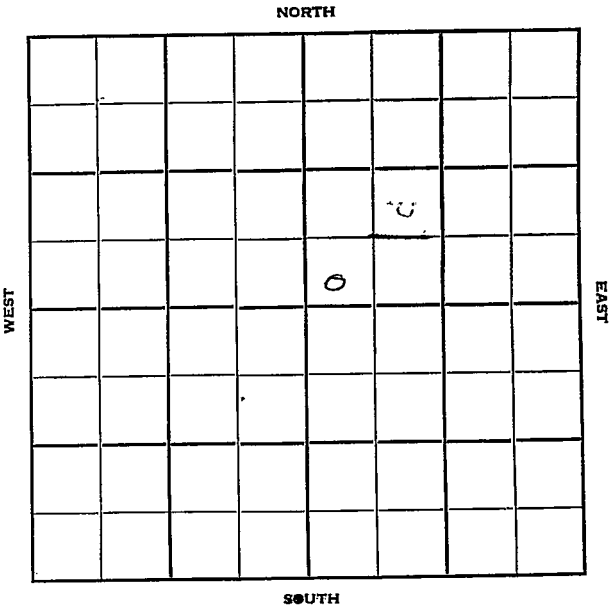

FORM 252-B
10M 10-50 PETROL

Stafford KANSAS

Sec. 8 Twp. 21 R. 13 W

Well No. # 1 Fischer Farm

Petroleum Inc & Omego Company

Garvey Hazel Contractor


____ Ft. from N. Line

330 Ft. from S. Line

____ Ft. from E. Line

330 Ft. from W. Line

SW SW NE

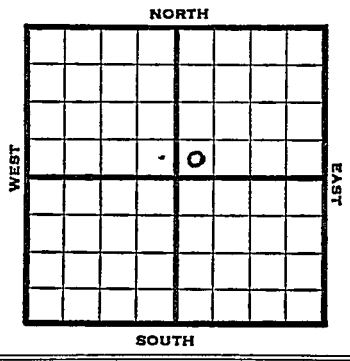

REPORT

1952	Elev. 1904'
1/16	Spud 1-13-52 8" @ 226 WOC
2/6	TD 3650 5"@ 3649 CO to 3645 97/3570-96
2/13	S/1 BOPH 150 A S/2¼ BOPH 2000 A S/1 BOPH plus 3% wtr. PB 3589' To A
2/20	5000 A 5½ BO & 8½ boph PB 3480 32/ 3470-78 500 A S/ 8 boph for 11 hrs. POP
3/5	NR
3/11	"
3/19	"
3/26	Spud 1-13-52 Oil well TD 3650' 8" @ 226 Heeb 3182' Br. lime 3304' Lans 3317 DST 3319-56 open 1 hr, rec 80' mud DST 3379-99, open 45 min. rec 15' mud DST 3428-44, open 1 hr, rec 2' hvy oil 28' mud. DST 3467-78open 1 hr, rec 75' HOCM 300' oil & muddy oil. Arb. 3570' DST 3568-76 open 1 hr. rec 375' clean oil DST 3576-86' open 1 hr, rec 750' free oil

OVER

1952
3/26 (Information continued)
DST 3586-96, open 1 hr, rec 150'
clean oil, 75' HOCM
DST 3596-3606 open 1 hr, rec 7' mud
TD 3650' 5" @ 3649' CO to 3645'
97/3570-96 S/1 BOPH 150 A
S/2¼ BOPH 2000 A S/1 BOPH
3% water PB 3589' 5000 A
S/½ BO 8½ BWPH PB 3480'
32/3470-78 500 A S/8 BOPH
Comp. 471 BOPD

COMPLETED

FORM 275 FOR SALE BY KANSAS BLUE PRINT CO.


County Stafford State Kansas

Sec. 8 (Blk. Twp.) 21 (Sur. Rge.) 13W Map No.

Operator Petroleum Inc. & Omego

Well No. 1 Farm Fischer

Elev. Location SW SW NE

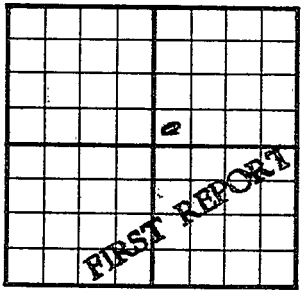

330 Ft. From S Line NE

330 Ft. From W Line Quarter

1st. Report JAN 1 6 1952

Completion

Remarks

Garvey - Contr.

Spudding Date 1-13-52

Drlg. Data Hazel

8" @ 226 W.O.C.

J. E. TYRA

FORM 275 FOR SALE BY KANSAS BLUE PRINT CO


County Stafford State Kansas

Sec. 8 (Blk. Twp.) 21 (Sur. Rge.) 13W Map No.

Operator Petroleum Inc. & Omego

Well No. 1 Farm Fischer

Elev. 1904 Location SW SW NE

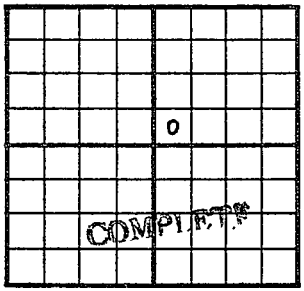

330 Ft. From S Line NE

330 Ft. From W Line Quarter

1st. Report

Completion MAR 26 1952

Remarks Hazel Pool

Garvey - Contr.

Spudding Date 1-13-52

Drlg. Data Oil well TD 3650

8" @ 226 Heeb. 3182 Br. lime 3304 Lans. 3317 DST 3319-56 open 1 hr. Rec. 80' mud DST 3379-99 open 45 min. Rec. 15' mud DST 3428-44 open 1 hr. Rec. 2' hvy oil 28' mud DST 3467-78 open 1 hr. Rec. 75' hocm 300' oil & muddy oil Arb. 3570 DST 3568-76 open 1 hr. Rec. 375' clean oil DST 3576-86 open 1 hr. Rec. 750' free oil DST 3586-96 open 1 hr. Rec. 150' clean oil 75' hocm DST 3596-3606 open 1 hr. Rec. 7' mud TD 3650 5" @ 3649 CO to 3645 97/ 3570-96

J. G. McGEHEE

Drlg. Data

S/ 1 boph 150 A S/ 2½ boph 2000 A

S/ 1 boph 3% water PB 3589 5000 A

S/ ½ bo 8½ bwph PB 3480 32/ 3470-78

500 A S/ 8 boph Comp. 471 popd

Scout Cards
Land Small Map
Land Wall Map
Land Map
Misc.
APR 2