


Section 36 Township 13 Range 11W
Well No. 1 Ellithorpe
Company Julian Oil & Royalty

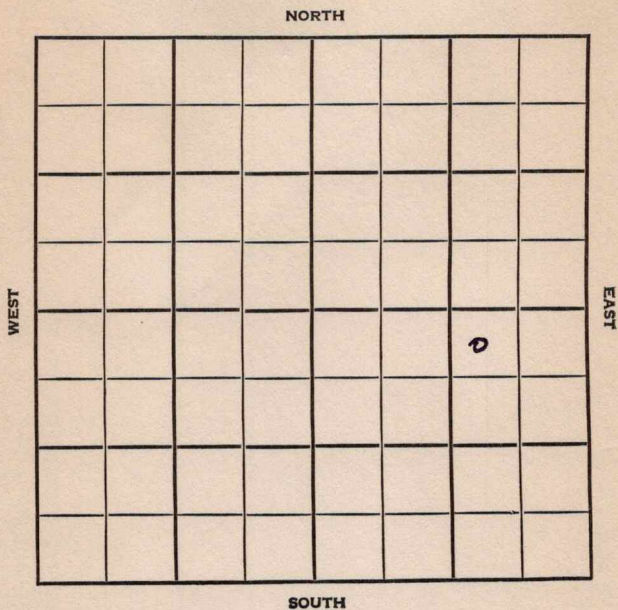

Russell

KANSAS

SEC.	TWP.	R.
36	13	14W

WELL NO.

#1 Ellithorpe

FARM

COMPANY

Julian Oil & Royalty

CONTRACTOR

Co. Tools.

Semi-Wildcat

330


Ft. from N. Line

Ft. from S. Line

990

Ft. from E. Line

Ft. from W. Line

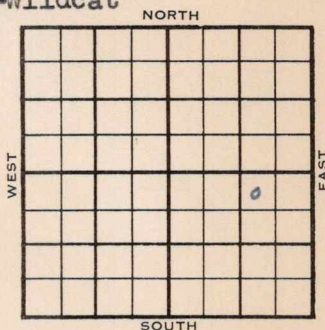

NW NE SE

1954

ELEVATION

1837'

REPORT

5/26

Spud 5-18-54
8" @

Anhy 792'

Drlg 900'

6/2

Drlg. 1740'

6/9

Drlg. 2340'

6/23

Drlg. 2805'

6/30

Lans 3042'

Drlg. 3190'

7/7

Drlg. ~~2230~~ 3320'

7/14

Spud 5-18-54 D & A TD 3334

Anhy 792 10" @ 800 8" @ 2415

Tarkio 2365 Top 2695 Lans 3042

Cong. 3330 TD 3334' D & A

ABANDONED

J. G. McGEHEE

County Russell State Kansas
 Sec. 36 (Blk. 13 (Sur. 14W Map No.
 (Twp.) (Rge.)
 Operator Julian Oil & Royalty
 Well No. 1 Farm Ellithorpe
 Elev. 1837 Location NW NE SE



330 Ft. From N Line SE
990 Ft. From E Line Quarter
 Ist. Report
 Completion JUL 14 1954
 Remarks Semi Wildcat
Co. tools
 Spudding Date 5-18-54

Drlg. Data D & A TD 3334
Anhy 792 10" @ 800 8" @ 2415
Tarkio 2365 Top. 2695 Lans. 3042
Cong. 3330 TD 3334
D & A