

KANSAS

Russell


Section 36 Township 13 Range 14W

Well No. 1 Ellithorpe

Company R. Shields et al

Hall-Gurney

NORTH

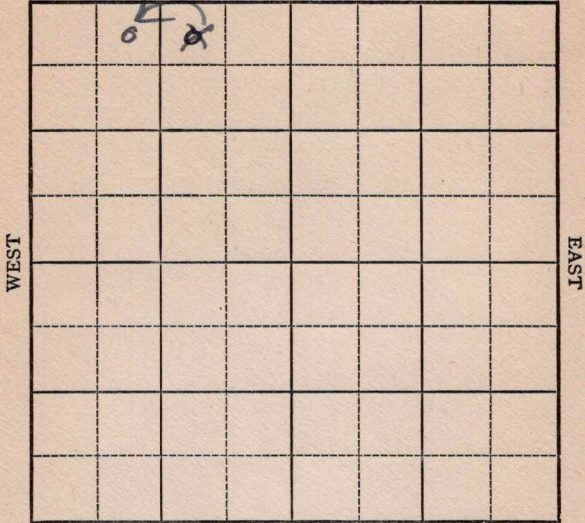

SOUTH

KANSAS

Russell ✓

Sec. 36 Twp. 13 R. 14W


Well No. 1 Ellithorpe Farm

R. Shields et al Company

Hall-Gurney Pool

Duke & Woods Contr.

330 Ft. from N. Line

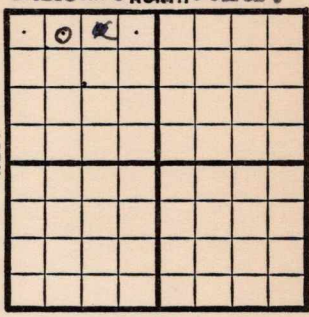

_____ Ft. from S. Line

~~990~~ Ft. from E. Line

990 Ft. from W. Line

~~NW NE NW~~

NE NW NW

1949 **Elev 1829'** REPORT

- 7/27 RUR
- 8/3 $10'' @ 120'$
rlg 2691'
- 8/10 **Lansing 2980'**
Arb. 3269'
TD 3275'
5'' @ 3270'
- 8/17 "
- 8/24 TD 3276'
Arb. 3266'
5'' @ 3271'
Pump 128 oil Pot
40° Gr.
Comp

COMPLETED

Map No. _____ Sec. 36 Twp. 13 R. 14W

Well No. 1 Ellithorpe

R. Shields etal. Company

Duke & Woods Contractor

NW NE NW

FIRST REPORT
SECTION PLAT

330 Ft. from N. Line

_____ Ft. from S. Line

990 Ft. from E. Line

_____ Ft. from W. Line

Russell County

Location _____

Rig up _____

Drilling and Remarks:

R U R

RECORD

Cased _____ in., _____ ft.

Sand _____

Gas _____

Oil _____

Total Depth _____

PRODUCTION

1st 24 hrs. Nat. _____

1st 24 hrs. after shot _____

Gas _____ Cu. Ft.

Dry Hole _____

Abandoned _____

Date

JUL 27 1949 19

S. J. LEWIS Scout

Kansas

Russell Pool

Map No. _____ Sec. 36 Twp. 13 R. 14W

Well No. 1 Ellithroffie

R. Shields etal.

Company _____

CORRECTION

Contractor _____

NE NW NW

SECTION PLAT

330 Ft. from N. Line

_____ Ft. from S. Line

_____ Ft. from E. Line

990 Ft. from W. Line

o			

Russell County

Location _____

Rig up _____

Drilling and Remarks:

reported

NW NE NW

RECORD

Cased _____ in., _____ ft.

Sand _____

Gas _____

Oil _____

Total Depth _____

PRODUCTION

1st 24 hrs. Nat. _____

1st 24 hrs. after shot _____

Gas _____ Cu. Ft.

Dry Hole _____

Abandoned _____

Date

AUG 3 1949 19

S. J. LEWIS

Scout

Kansas

Map No. K72 Sec. 36 Twp. 13 R. 14W

Well No. 1 Ellithorpe

R. Shields et al. Company

COMPLETE

Contractor

NE NW NW

E11829
SECTION PLAT

0			

330 Ft. from N. Line

_____ Ft. from S. Line

_____ Ft. from E. Line

990 Ft. from W. Line

Russell County

Location _____

Rig up _____

Drilling and Remarks:

CR 3266

5" @ 271

Prod 125 oil Prod

40 @ 271

RECORD

Cased _____ in., _____ ft.

Sand _____

Gas _____

Oil _____

Total Depth 8276

PRODUCTION

1st 24 hrs. Nat. _____

1st 24 hrs. after shot _____

Gas _____ Cu. Ft.

Dry Hole _____

Abandoned _____

Date

AUG 24 1949 19

S. J. LEWIS

Scout