

KANSAS


Russell

Section 36 Township 13 Range 14-W

Well No. #2 Ellipthrope

Company Shields Oil
Russell Pool

NORTH

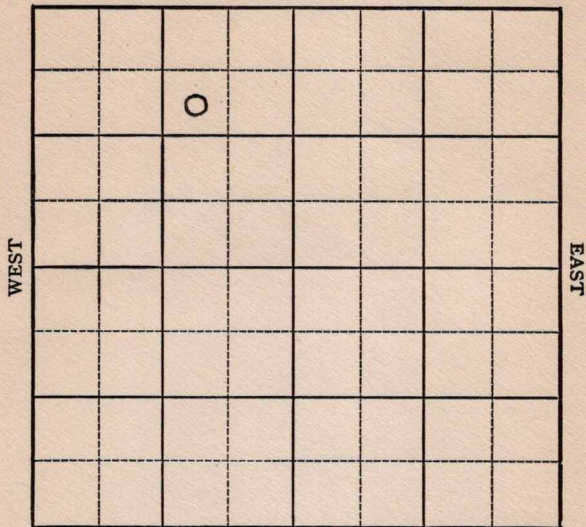

SOUTH

Sec. 36 Twp. 13 R. 14W

KANSAS

Well No. 2 Ellipthrope Farm

Shields Oil

Russell Pool Duke & Wood Contr. Company


990 Ft. from N. Line

_____ Ft. from S. Line

990 Ft. from E. Line

_____ Ft. from W. Line

SW NE NW

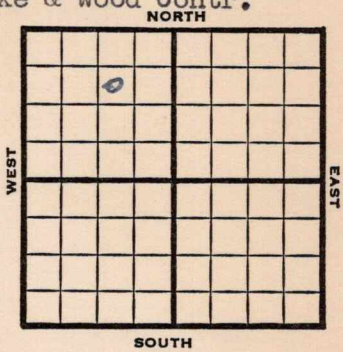

1949

Elev. 1832' REPORT

8/24

8" @ 120'
Drlg 300'

8/31

Drlg. 2870'

9/7

Drlg. 3020'

9/14

"

9/21

Lansing 2989'
5" @ 2990'

Drlg. 3042'

9/28

Drlg 3093'

10/5

Drlg 3210'

10/12

Drlg 3272'

10/19

"

10/26

Arb 3248'
TD 3288'

ABANDONED

Map No. _____ Sec. 36 Twp. 13 R. 14W

Well No. 2 Ellipthrope

Shields Oil Company

Duke & Wood Contractor

SW NE NW

FIRST REPORT
SECTION PLAT

990 Ft. from N. Line

_____ Ft. from S. Line

990 Ft. from E. Line

_____ Ft. from W. Line

Russell County

Location _____

Rig up _____

Drilling and Remarks:

8" @ 120

drlg. 300

RECORD

Cased _____ in., _____ ft.

Sand _____

Gas _____

Oil _____

Total Depth _____

PRODUCTION

1st 24 hrs. Nat. _____

1st 24 hrs. after shot _____

Gas _____ Cu. Ft.

Dry Hole _____

Abandoned _____

Date

AUG 24 1949 19

S. J. LEWIS

Scout

Kansas

Map No. _____ Sec. 36 Twp. 13 R. 14W

Well No. 2 Ellipthrope

Shields Oil _____ Company

ABANDONED _____ Contractor

SW NE NW

E. 11832
SECTION PLAT

990 _____ Ft. from N. Line

_____ Ft. from S. Line

990 _____ Ft. from E. Line

_____ Ft. from W. Line

	0		

Russell County

Location _____

Rig up _____

Drilling and Remarks:

Cur 3248.

RECORD

Cased _____ in., _____ ft.

Sand _____

Gas _____

Oil _____

Total Depth 3288

PRODUCTION

1st 24 hrs. Nat. _____

1st 24 hrs. after shot _____

Gas _____ Cu. Ft.

Dry Hole _____

Abandoned _____

Date

OCT 26 1949

19

S. J. LEWIS

Scout