


Section 1 Township 13 Range 15W

Well No. #1 S. S. Ranch

Company Harms & Knight

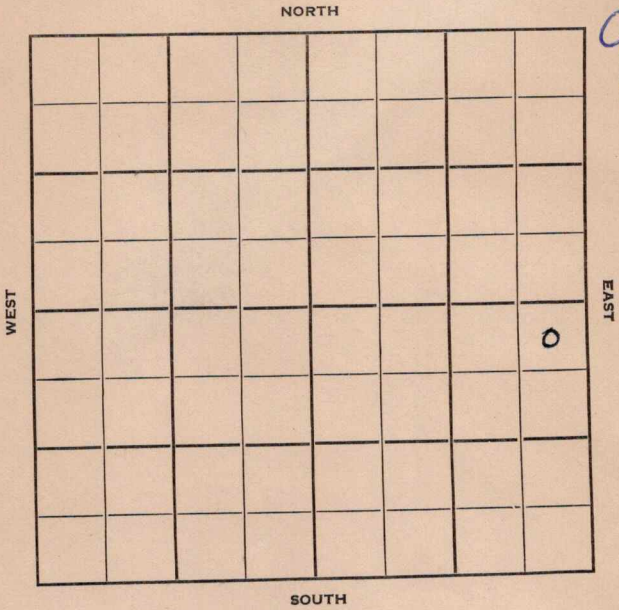

KANSAS

Russell

Sec. 1 Twp. 13 R. 15-W ✓

Well No. #1 S S Ranch Farm

Harms & Knight Company

Contractor


Wildcat

330 Ft. from N. Line

Ft. from S. Line

330 Ft. from E. Line

Ft. from W. Line

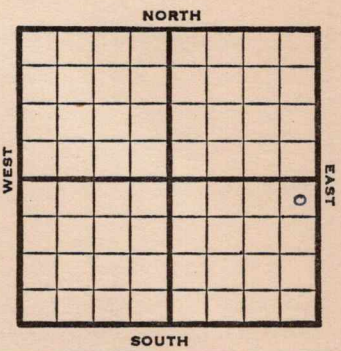

NE NE SE

1950

Elev 1613'

REPORT

2/1
/2/22

Location

TD 3186'

8"@ 378'

5"@ 2923'

Topeka 2417'

Heeb 2743'

Lans 2798'

Cong 3095'

TD 3186' in Cong

D&A

Aband.

ABANDONED

Map No. _____ Sec. 1 Twp. 13 R. 15W

Well No. 1 S.S. Ranch

_____ Harms & Knight _____ Company

_____ Contractor

NE NE SE

SECTION PLAT

330 Ft. from N. Line

_____ Ft. from S. Line

330 Ft. from E. Line

_____ Ft. from W. Line



Russell County

Location _____

Rig up _____

Drilling and Remarks:

RECORD

Cased _____ in., _____ ft.

Sand _____

Gas _____

Oil _____

Total Depth _____

PRODUCTION

1st 24 hrs. Nat. _____

1st 24 hrs. after shot _____

Gas _____ Cu. Ft.

Dry Hole _____

Abandoned _____

Date

FEB 1 1950 19

J. E. TYRA

Scout

Kansas

Map No. _____ Sec. 1 Twp. 13 R. 15W

Well No. 1 S. S. Ranch

Harms & Knight Company

Contractor

E. 1613

NE NE SE

SECTION PLAT

330 Ft. from N. Line

_____ Ft. from S. Line

330 Ft. from E. Line

_____ Ft. from W. Line



Russell County

Location _____

Rig up _____

Drilling and Remarks:

8" @ 378
5" @ 2923
Topok 2417
Kub 2743
Lans 2798
Long 3095
T.D. 3186 in long

Date

D + A.

RECORD

Cased _____ in., _____ ft.

Sand _____

Gas _____

Oil _____

Total Depth 3186

PRODUCTION

1st 24 hrs. Nat. _____

1st 24 hrs. after shot _____

Gas _____ Cu. Ft.

Dry Hole _____

Abandoned _____

FEB 22 1950 19

J. E. TYRA

Scout