


Russell

SECTION 1 TOWNSHIP 13S RANGE 15W

WELL NO. #5 Shaffer

COMPANY Peel-Hardman

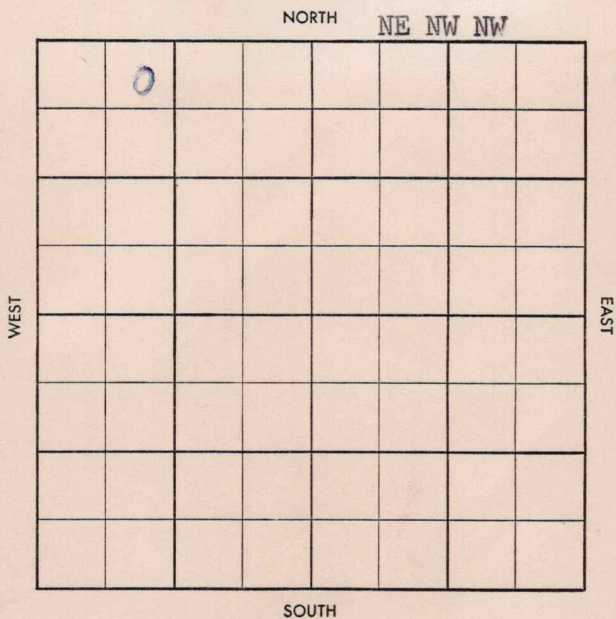

132287

V3

County Russell Elev. _____

Sec. 1 Twp. 13 Rge. 1 5W

Company Peel-Hardman

Farm Name Shaffer No. 5

TOPS	DEPTH	LOG	DATUM
Anh.			
Tp.			
H.			
Tr.			
Dg.			
B. L.			
L.			
K.C.			
B.K.C.			
Ce.			
C.			
M.			
M.			
K.			
Mz.			
Mq.			
V.			
S.			
S.			
A.			
R.			
Pf.			
G.			
T.D.			

Loc. in Sec. _____

NE NW NW

250' NL

550' EL

Geol. _____

Contr. _____

Peel Bros.

Pool _____

S & S



Date Comm. _____

Location

Co.

Lse.

No.

Sec.

T.

R.

Twp ~~_____~~ Pool ~~_____~~
 Co. ~~_____~~ Facet ~~_____~~

S-513-B

CORRECTION

County Russell Elev. 16850'
 Sec. 1 Twp. 13 Rge. 15W
 Company Peel-Hardman
 Farm Name Shaffer No. 5

TOPS	DEPTH	LOG	DATUM
Anh.			
Tp.			
H.	2763	2766	
Tr. <u>PO 4yo</u>		2785	
Dg.			
B.L.			
L.	2815	2818	
K.C.			
B.K.C.			
Ce.			
C.			
M.			
M.			
K.			
Mz.			
Mq.			
V.			
S.			
S.			
A.	3094	3088	
R.			
Pf.			
G.			
T.D.	3110		

Loc. in Sec. _____
 NE NW NW
 250' NL
 1550' EL
 01' NW/4

Geol. _____
 Contr. _____
 Pool _____
 S & S

COMPLETE
 APR 23 '58

Date Comm. 1-27-58 8"710/425
 Location JAN 29 '58 MIRT FEB 5 '58 3110
FEB 12 '58 DST 2853-65 60" 1280
gip 120' 069cm 60' MO BHP
380/15 no log 5 1/2 3109
MIRT FEB 19 '58 CO 3107 36/3088
-3100 1 1/2 NS ~~25/2815~~ 25/
3072-74 1/2 5 BWP NS
3 hrs PB 2900 25/2856-60
1/2 9 BOPH NW 5 hrs POP
wo pot FEB 26 '58 MAR 5 '58 MAR 12 '58 MAR 19 '58

FORM 513-1 SUNRAY

MAR 26 '58 APR 2 '58 APR 9 '58 P 2 1/2 BOPD NW

8 hrs APR 16 '58 APR 23 '58 Phy 60 BOPD NW

Lsg 2856-60

PB 2400

1-13-15W

ne nw nw