FORM 51 10M 8-47


KANSAS

Russell

Section 5 Township 13 Range 15W

Well No. #1 Tracey

Company ~~Grow & Tracey~~

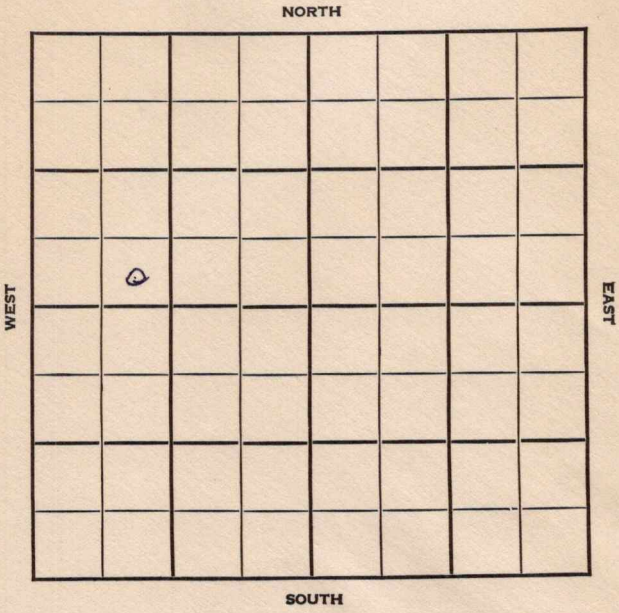

FORM 252-A
5M 4-48 PETROL

KANSAS Russell

Sec. 5 Twp. 13 R. 15W

Well No. #1 Tracey Farm

Grow & Tracey Company

Wildcat


____ Ft. from N. Line

330' Ft. from S. Line

____ Ft. from E. Line

990' Ft. from W. Line

SE SW NW

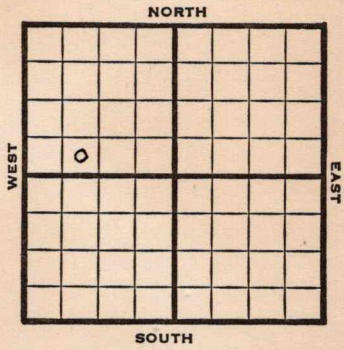

1948	Eli 1804' REPORT
5/26	Location
6/1	8" @ 200' Drlg. 1308'
6/9	Drlg 2858'
6/16	Lansing 2983' Arbuckle 3270' TD 3273' 5" @ 3272' RUST
6/23	Perf 20 shots 3190-3200-500 acid V SSO
6/29	Water PB 3075'
7/8	"
7/14	PB 3109'
7/21	"
7/28	"
8/4	"
8/11	"
8/18	"
8/25	"
9/1	18 shots 2881-85 - 1000 acid Swb 1/2 bbl. oil a day
9/8	" "
9/14	" "
9/21	" "
9/29	" "
10/6	" "

OVER

735696

1948

10/13 18 shots 2881-85
1000 acid
Swb ½ bbl oil a day

10/19 "

10/26 "

11/3 "

11/10 "

11/16 "

11/23 "

11/30 "

12/8 "

12/15 Arb. 3270'
Aband.

ABANDONED

Form 26—200 Bks.—1-48—Palace

Wildcat

Kansas

Map No. _____ Sec. 5 Twp. 13 R. 15W


Well No. 1 Tracey

Grow & Tracey Company

FIRST REPORT Contractor

SE SW NW

SECTION PLAT

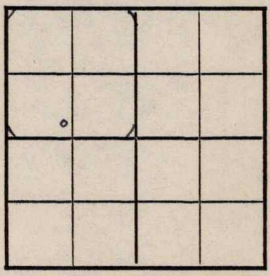

_____ Ft. from N. Line

330 Ft. from S. Line

_____ Ft. from E. Line

990 Ft. from W. Line

Russell County

Location x

Rig up

Drilling and Remarks:

RECORD

Cased _____ in., _____ ft.

Sand

Gas

Oil

Total Depth

PRODUCTION

1st 24 hrs. Nat.

1st 24 hrs. after shot

Gas _____ Cu. Ft.

Dry Hole

Abandoned

Date

MAY 26 1948 19____ S. J. LEWIS Scout

Form 26 200 Bks. 9-48 Petrol. Kansas

Wildcat

Map No. 72 Sec. 5 Twp. 13 R. 15W

Well No. 1 Tracey


Grow & Tracey Company

ABANDONED Contractor

SE SW NW

E 4,1804

SECTION PLAT

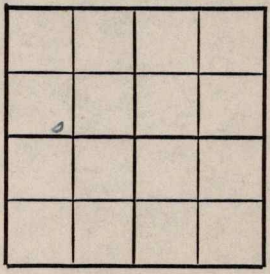

____ Ft. from N. Line

330 Ft. from S. Line

____ Ft. from E. Line

990 Ft. from W. Line

Russell County

Location

Rig up

Drilling and Remarks:

Cir 3270

RECORD

Cased ____ in., ____ ft.

Sand

Gas

Oil

Total Depth 3273

PRODUCTION

1st 24 hrs. Nat.

1st 24 hrs. after shot

Gas ____ Cu. Ft.

Dry Hole

Abandoned

Date

DEC 15 1948 19 S. J. LEWIS Scout