

KANSAS


Russell

Section 6 Township 13 Range 15W

Well No. 1 Brungardt

Company Stearns Drlg.

Fairport
NORTH

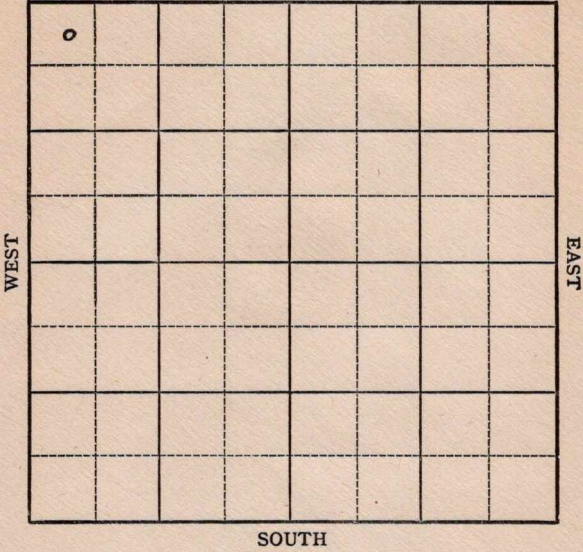

KANSAS

Russell



Sec. 6 Twp. 13 R. 15W

Well No. #1 Brungardt Farm

Stearns Drlg. Company


Fairport Pool

330' Ft. from N. Line

_____ Ft. from S. Line

_____ Ft. from E. Line

410' Ft. from W. Line

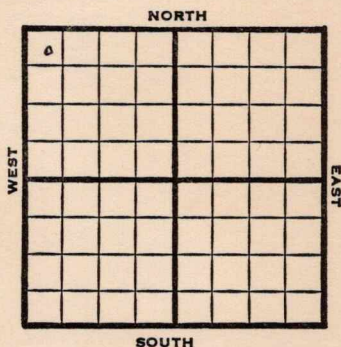

NW/C Twin Well

1949

Elev 1883' REPORT

- 3/9 8" @ 216'
Lans. 3013'
Arb. 3291'
TD 3320'
- 3/16 5" @ 3320'
24 shots 3305-09'
20 gal oil ~~Pot~~ P.H.
- 3/23 Squeeze
- 3/30 "
- 4/6 36 shots 3286-96'
Swb 35 bbls oil 8 hrs.
- 4/12 "
- 4/20 "
- 4/27 "
- 5/4 "
- 5/11 TD 3320'
Arb. 3291'
5" @ 3320'
Perf
Pump 35 Oil SW Pot
38° Gr.
Comp

COMPLETED

Map No. H 72 Sec. 6 Twp. 13 R. 15W

Well No. 1 Brungardt

Stearns Drlg. Company

COMPLETE

Contractor

NW/C

E. 11873

SECTION PLAT

330 Ft. from N. Line

_____ Ft. from S. Line

_____ Ft. from E. Line

410 Ft. from W. Line

0			

Russell County

Location _____

Rig up _____

Drilling and Remarks:

Per 3291

5" @ 3320

Perf.

Perf. oil SW

Perf.

38-4

RECORD

Cased _____ in., _____ ft.

Sand _____

Gas _____

Oil _____

Total Depth 3320

PRODUCTION

1st 24 hrs. Nat. _____

1st 24 hrs. after shot _____

Gas _____ Cu. Ft.

Dry Hole _____

Abandoned _____

Date

MAY 11 1949 19

S. J. LEWIS Scout

Map No. _____ Sec. 6 Twp. 13 R. 15^W

Well No. 1 Brungardt

Stearns Drlg. Company

FIRST REPORT Contractor

NW/C

SECTION PLAT

330 Ft. from N. Line

_____ Ft. from S. Line

_____ Ft. from E. Line

410 Ft. from W. Line

0			

Russell County

Location _____

Rig up _____

Drilling and Remarks:

twin well

8" @ 216

Lans. 3013

Arb. 3291

TD 3320

5" @ 3320

RECORD

Cased _____ in., _____ ft.

Sand _____

Gas _____

Oil _____

Total Depth _____

PRODUCTION

1st 24 hrs. Nat. _____

1st 24 hrs. after shot _____

Gas _____ Cu. Ft.

Dry Hole _____

Abandoned _____

Date

MAR 9 1949 19

S. J. LEWIS Scout