
Russell

Form 51—5M—9-28—27423

Map No. KANSAS Sec. 6 Twp. 13 R. 15-W

Well No. 1- Leonard Farm

Texas Oil Company

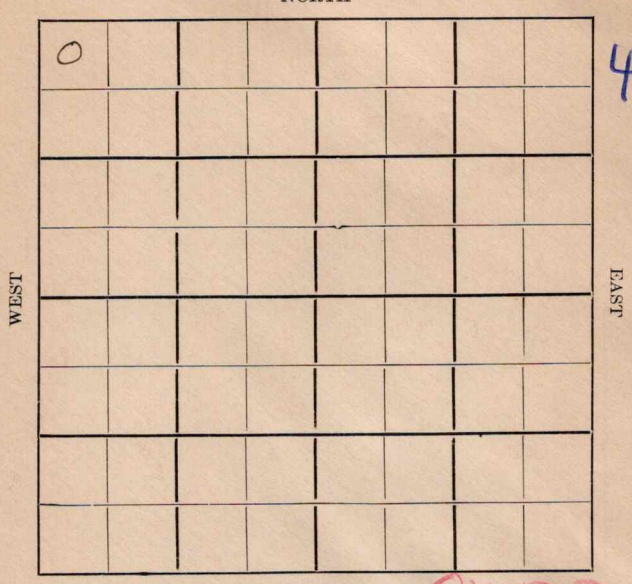

OWDD

Location

Drilling Remarks

Rig Up

Drilling Remarks

RECORD

Cased ..... in. ..... ft.

Sand

Gas

Oil

Total Depth

PRODUCTION

1st 24 hrs. Nat.

1st 24 hrs. after shot

Gas ..... cu. ft.

Dry Hole

Abandoned

Russell

FORM 252A-5M-12-28-PETROL

Map No. KANSAS Sec. 6 Twp. 13 R. 15 W

Well No. 1- Leonard Farm


Texas Oil Company

330 Ft. from N. Line

Ft. from S. Line

Ft. from E. Line

330 Ft. from W. Line

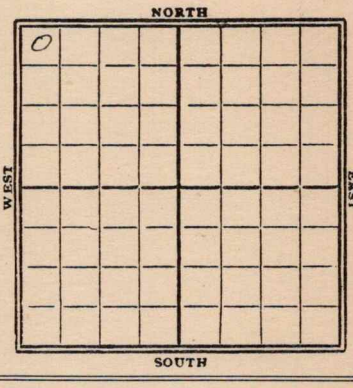

1929

Date	REPORT
2/20	Location
2/27	Bldg Rig
3/6	Rig
3/13	"
3/20	Rigg up.
3/27	Drlg 540'
4/3	" 940'
4/10	" 1960
4/17	" 2440'
4/24	" 2530'
5/1	" 2760'
5/8	Oswald sd 2996
	Pay 3008-16 T.D. 3018
	swabbed 42 bbls 19 hrs
5/15	Oswald sand 2996'
	Pay 3008-16'
	T.D. 3075'
	swab 55 bbls oil
	Comp.
1931	OWDD
10/28	Old TD 3075
	R.U. to deepen

735723

11/4- TD. 3087
swab 40 bbl oil
and 40 " water
in 24 hrs

11/10- Old TD. 3075
Deepened to
TD. 3087
Made 25 bbl oil
and 5 " water
Comp.

FORM 26 250 BKS. 4-28 WESTERN

Russell

MAP NO. KANSAS SEC. 6 TWP. 13 R. 15W


no map

WELL NO. 1 Leonard

Texas Oil COMPANY

CONTRACTOR

SECTION PLAT

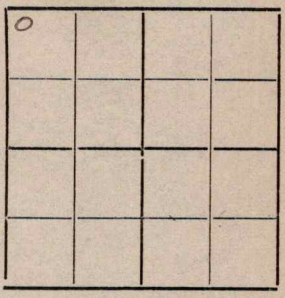

330 FT. FROM N. LINE

FT. FROM S. LINE

FT. FROM E. LINE

330 FT. FROM W. LINE

FIRST REPORTS

LOCATION ✓

RIG UP

DRILLING AND REMARKS:

RECORD

CASED IN., FT.

SAND

GAS

OIL

TOTAL DEPTH

PRODUCTION

1ST 24 HRS. NAT.

1ST 24 HRS. AFTER SHOT

GAS CU. FT.

DRY HOLE

ABANDONED

DATE

FEB 20 1929

192

S. J. LEWIS SCOUT

Form 26—1M Bks—9-28


Map No. KANSAS Sec. 6 Twp. 19 R. 25 W

Well No. 1 Leonard

Texas Oil Company

Contractor

SECTION PLAT

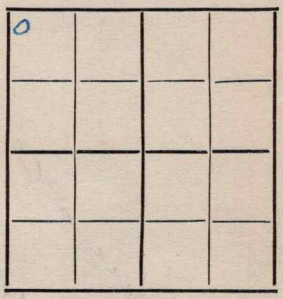

330 Ft. from N. Line

Ft. from S. Line

Ft. from E. Line

330 Ft. from W. Line

COMPLETED

Location

Rig up

Drilling and Remarks:

Oswald Sand
2996
Pay 3005-16
Swabbed 50 BO & 4 W

RECORD

Cased in., ft.

Sand

Gas

Oil

Total Depth 3075

PRODUCTION

1st 24 hrs. Nat.

1st 24 hrs. after shot

Gas Cu. Ft.

Dry Hole

Abandoned

Date

MAY 15 1929 192

S. J. LEWIS Scout

Form 26—1M Bks.—9-26

Russell

72 KANSAS Map No. Sec. 6 Twp. 13 R. 15 W

Well No. 1 Leonard

Texas Co Company

Contractor

FIRST REPORTS


330 Ft. from N. Line

Ft. from S. Line

Ft. from E. Line

330 Ft. from W. Line

SECTION PLAT

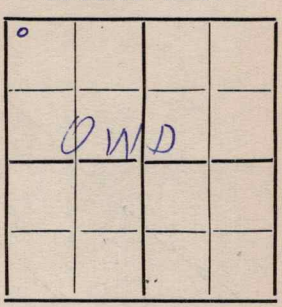

Location

Rig up

Drilling and Remarks:

Rigging up to Deepen

RECORD

Cased in., ft.

Sand

Gas

Oil

Total Depth 3075

PRODUCTION

1st 24 hrs. Nat.

1st 24 hrs. after shot

Gas Cu. Ft.

Dry Hole

Abandoned

Date

OCT 2 8 1931

192

CHAS. L. SHERWOOD Scout

Form 26—1M Bks.—9-26

Russell

72 KANSAS

Map No. ..... Sec. 6 Twp. 13 R. 15 W

Well No. 1 Leonard

Texas Co ..... Company

..... Contractor

COMPLETED


330 Ft. from N. Line

..... Ft. from S. Line

..... Ft. from E. Line

330 Ft. from W. Line

SECTION PLAT

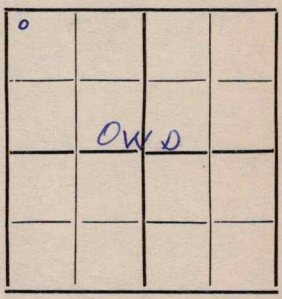

Location .....

Rig up .....

Drilling and Remarks:

Old TD 3075

Deepened to 3087

25 Bbls Oil

5 " Water

RECORD

Cased ..... in., ... ft.

Sand .....

Gas .....

Oil .....

Total Depth 3087

PRODUCTION

1st 24 hrs. Nat. .....

1st 24 hrs. after shot .....

Gas ..... Cu. Ft.

Dry Hole .....

Abandoned .....

Date

NOV 10 1931

CHAS. L. SHERWOOD

..... 192..... ..... Scout