


Section 19 Township 18 Range 25WWell Number #1 Tenny~~F. H. McKeough~~Company ~~Newton Development~~*Oriental Oil*

NORTH

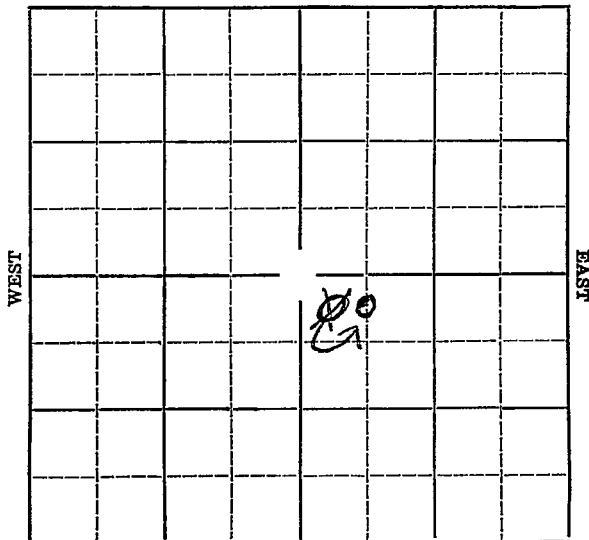

SOUTH

O. W. P. B.

Map No. **KANSAS** Sec. **19** Twp. **18** R. **25W**Well No. **#1 Tenny** Farm~~Newton Development~~~~S. H. McKeough~~

Company

Oriental Oil NORTH**330'** Ft. from N. Line

Ft. from S. Line

Ft. from E. Line

~~660~~
530' Ft. from W. Line

Elev. 2541

WEST

EAST

SOUTH

Date **1936** REPORT **O. W. P. B.**

5/20 Cellar.
5/28 Building rig.
6/4 Spud and shut down.
6/11--6/18--
6/25 Spud 75'.
7/2 No report.
7/9 Drlg. 527'.
7/16 Drlg. 1530'.
7/23--
7/30 Shut down.
8/6--8/13--
8/20 15" @ 530'. Shut down.
8/27--
9/3 12" @ 810'. Drlg. 941'.
9/10 Anhydrate 1185'. 12" @ 1198'.
Clean out.
9/18--
9/24 Drlg. 1292'.
10/1 Drlg. 1640'.
10/8 Anhydrate 1791'. Run 10".
10/15 1907' shut down.
10/22--

OVER

1936

10/29-10" @ 1942'. Drlg. 2245'.

11/6-2450 S. D.

11/12-----

11/19 T. D. 2717'. Pulled in rig.

11/27--- 12/3--12/10

12/10 Rigging up

12/17 " " 12/24--

12/29 Shut down.

1937

1/7 Drlg. 3155'.

1/14 Shut down 3155'.

1/21 H.F.W. 3319 T. D. 3323'.

Under Ream 8".

1/28 Drlg. 3325'.

2/4 Shut down 3415'

2/11 Topeka 3524, Hole Full water
3587 Under ream 8"

2/19 Shut Down.

2/26 8" @ 3595'. T.D. 3600'. CleanOut

3/4 Hole Full water 3605' Drlg. 3810'

3/11 Topeka 3510'. KCL 3652'.
T.D. 3895'. underream 8".

3/18 Drlg. 3900'

3/25 Water 3980'. 6" @ 3965'.
Drlg. 4005'.

4/2 Shut Down 4005'

4/8 Conglomerate 4044' Mississippi
Chert 4050' TD 4052' under ream 6"

4/16 Hole full water 4000-4010'.
Underream 6".

OVER

1937

4/23 4160' underream 6".

4/30 Drlg. 4200'.

5/7 6" @ 4240'.
SD 4300'.

5/14 T.D. 4379' SD.

5/21 U. R. 6".

5/28 " "

6/4 Shut down.

6/7--Oil well some kind (Tel-~~WALK~~ Hatfield)

6/7--~~Tel-~~WALK~~ Hatfield~~

1/2 foot in pay

T.D. ~~4381~~ 4373

Pay ~~4380 1/2 - 4381~~ 10 hour filled up 2000
feet oil in hole

Shut in for a while well filled up
3400 feet of oil

Swabbed 2 hours swabbed 50 barrels oil

Oil tests 44 at 77

U.R. 6" casing

The Wells the Continental drilled in this
area have not todote determined where the
oil is coming from. (Orval Mannschreck)

6/14--Pulling big pipe (Tel)

6/19--Corrected T.D. from 4381 to 4373
Drilled from 4373 to 4380 Cleaned out
Filled up 1000 feet in 2 1/2 hours
Shut down over night This morning
started drilling Didn't test
Did not test fill up when drilled plugs
(Tel)

6/22--Drilled to T.D. 4380
2280 feet oil 36 hours
Acidizing now (Tel)

1937

6/25 T.D. 4381½' (Corrected)
To 4373'. @ 4387, 2700' oil
30 hrs. 2000 acid.

Swab 84 bbls. 4½ hrs and
lowered fluid to 800' off
bottom refilled to 2100' 14
hours. Drlg. 4389'.

7/2 T.D. 4406'. 3200' oil.

7/9 " " " "

7/16 SD 4406'.

7/23 " "

7/30- " "

8/6 " "

8/13 " "

8/20 " "

8/28 " "

9/3 " "

9/10 " "

9/17 " "

9/24 " "

10/2 " "

10/8 3000 acid. Fishing swab.

10/15 Was not given the acid treatment
Deepened to 4450' T.D.

Small inc. in oil 4406-11'.

OVER

1937

10/20 - 6" @ 4371'.

Miss. 4378 $\frac{1}{2}$ '.

T.D. 4450'.

3000 acid @ T.D. 4406'.

Pumped 50 bbls. oil in 24 hrs.
and pumped off.

Potential 50 bbls.

COMPLETED

1937

O.W.P.B.

11/23 Old T.D. 4450'.

Originally Comp. for 50 bbls.

Acidized With 3000 gallons.

No help.

P.B. 4390'.

Perforated pipe w/100 shots
4375-85'.

2500' oil.

4000' acid.

Potential 1353 bbls.

FIRST REPORT

and
COMPLETED

Continental had no information on
this well.

KANSAS

Map No. 77 Sec. 19 Twp. 18 R. 25WWell No. 1 PennyNewton Development Company

Contractor

SECTION PLAT

		0	

230 Ft. from N. Line

_____ Ft. from S. Line

_____ Ft. from E. Line

380 Ft. from W. Line

FIRST REPORT

Location _____

Rig up _____

Drilling and Remarks:

Cellar.

RECORD

Cased _____ in., _____ ft.

Sand _____

Gas _____

Oil _____

Total Depth _____

PRODUCTION

1st 24 hrs. Nat. _____

1st 24 hrs. after shot _____

Gas _____ Cu. Ft.

Dry Hole _____

Abandoned _____

Date

MAY 20 1936 19

S. J. LEWIS

Scout

Map No. 77 Sec. 19 Twp. 18 R. 25W.

Well No. 1 Tenny

B. H. McTeague Company

Contractor

SECTION PLAT

		0	

230 Ft. from N. Line

_____ Ft. from S. Line

_____ Ft. from E. Line

230 Ft. from W. Line

CORRECTION

Location _____

Rig up _____

Drilling and Remarks:

*Reported
Newton Development
Co.,*

RECORD

Cased _____ in., _____ ft.

Sand _____

Gas _____

Oil _____

Total Depth _____

PRODUCTION

1st 24 hrs. Nat. _____

1st 24 hrs. after shot _____

Gas _____ Cu. Ft.

Dry Hole _____

Abandoned _____

Date

SEP 16 1936 19

S. J. LEWIS Scout

Ness

KANSAS

Map No. 77 Sec. 19 Twp. 18 R. 25WWell No. 1 TennyS H Keoughen Company

Contractor

COMPLETED

SECTION PLAT

		0	

NW SE

330 Ft. from N. Line

_____ Ft. from S. Line

_____ Ft. from E. Line

330 Ft. from W. Line

Location _____

Rig up _____

Drilling and Remarks:

3000 Acid @ TD 4406Pumped 50 Bbls oil
IN 24 hrs & pumped
OFFPOT 50

RECORD

Cased 6 in., 4371 ft.~~Sand~~ MISS 4378 1/2

Gas _____

Oil _____

Total Depth 4450

PRODUCTION

1st 24 hrs. Nat. _____

1st 24 hrs. after shot _____

Gas _____ Cu. Ft.

Dry Hole _____

Abandoned _____

Date

OCT 20 1937 19H. D. Hatfield Scout

Map No. 77 Sec. 19 Twp. 18 R. 25WWell No. 1 TennyOriental Oil

Company

FIRST REPORT

Contractor

COMPLETED

C N L NW SE

330 Ft. from N. Line Ft. from S. Line Ft. from E. Line660 Ft. from W. Line**SECTION PLAT**

		0	

O, W, P, B.Location Rig up

Drilling and Remarks:

*O.T.D. 4450
originally comp. For 50 bbls**Acidized w/3000 gal H₂O**no help**P.B. 4390 perforated**Pipe w/100 shots 4375-85**2500' oil 4000 Acid**pot-1353 bbls***RECORD**Cased in., ft.Sand Gas Oil Total Depth **PRODUCTION**1st 24 hrs. Nat. 1st 24 hrs. after shot Gas Cu. Ft.Dry Hole Abandoned

Date

NOV 23 1937

19

H. D. Hatfield

Scout

Map No. _____ Sec. 19 Twp. 18 R. 25^WWell No. 1 - TerryOriental Oil Company

Contractor _____

CORRECTION**SECTION PLAT**

		0	

330 Ft. from N. Line

_____ Ft. from S. Line

_____ Ft. from E. Line

660 Ft. from W. Line

Location _____

Rig up _____

Drilling and Remarks:

Originally carried and completed as located in NW SE - Has been corrected TO CNL NW SE operators name is also changed from

RECORD

Cased _____ in., _____ ft.

Sand _____

Gas _____

Oil _____

Total Depth _____

PRODUCTION

1st 24 hrs. Nat. _____

1st 24 hrs. after shot _____

Gas _____ Cu. Ft.

Dry Hole _____

Abandoned _____

Date

NOV 23 1937

H. D. Hatfield

19

Scout