


Section 6 Township 13 Range 15 WWell No. # 1 BrungardtCompany F. J. Haynes

NORTH

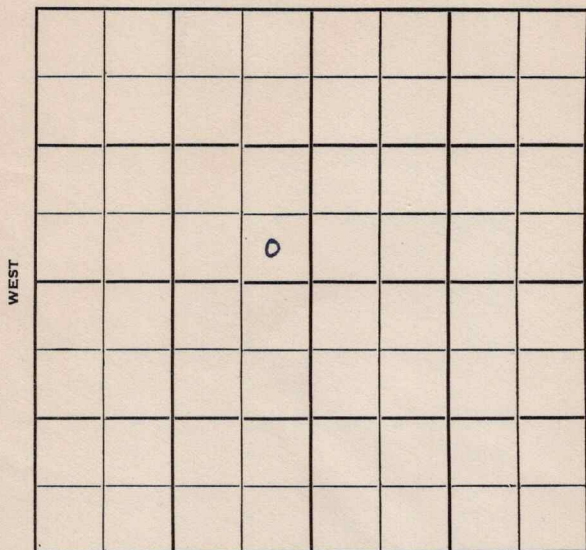

SOUTH

Russell

KANSAS

Sec. 6 Twp. 13 R. 15W ✓

Well No. #1 Brungardt Farm

F. J. Haynes Company

Contractor

Fairport Pool


Ft. from N. Line

330' Ft. from S. Line

330' Ft. from E. Line

990 Ft. from W. Line

SE SW NW
~~SE SE NW~~

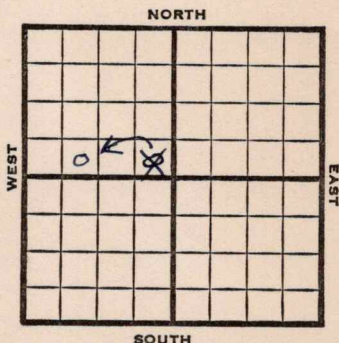

1951 Rev. 1884' REPORT

2/21 Location
4/25 Spud 2-24-51
D & A TD 3330'
12" @ 596 Anhy 940' 10" @ 940
KC 3043' Cong. 3290' SO 3280-90'
3 GOPH TD 3330
D & A

ABANDONED

J. E. TYRA

County Russell State Kansas
 Sec. 6 (Blk.) 13 (Sur.) 15W Map No.

Operator F. J. Haynes

Well No. 1 Farm Brungardt

Elev. 1884 Location SE SW NW



330 Ft. From S Line NW

990 Ft. From W Line Quarter

1st. Report

Completion APR 25 1951

Remarks Fairport Pool

Spudding Date 2-24-51

Drlg. Data D & A TD 3330

12" @ 596 Anhy 940 10" @ 940 KC 3043

Cong. 3290 SO 3280-90 3 goph TD 3330

D & A


J. E. TYRA

Kansas

Map No. _____ Sec. 6 Twp. 13 R. 15WWell No. 1 Brungardt_____
F. J. Haynes Company_____
CORRECTION Contractor

SE SW NW

SECTION PLAT

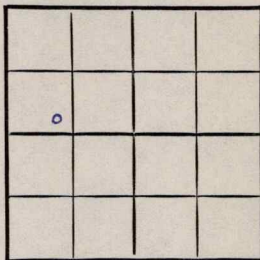Ft. from N. Line330 Ft. from S. Line_____
Ft. from E. Line990 Ft. from W. Line

Russell County

Location _____

Rig up _____

Drilling and Remarks:

Reported

1221 SE SE NW

RECORD

Cased _____ in., _____ ft.

Sand _____

Gas _____

Oil _____

Total Depth _____

PRODUCTION

1st 24 hrs. Nat. _____

1st 24 hrs. after shot _____

Gas _____ Cu. Ft.

Dry Hole _____

Abandoned _____

Date

APR 25 1951

19

J. E. TVDA

Scout