

Ness

KANSAS

22

18


26W

SECTION _____ TOWNSHIP _____ RANGE _____

WELL NO. #1 Edwards "A"

COMPANY CRA & Northern Pump

NORTH

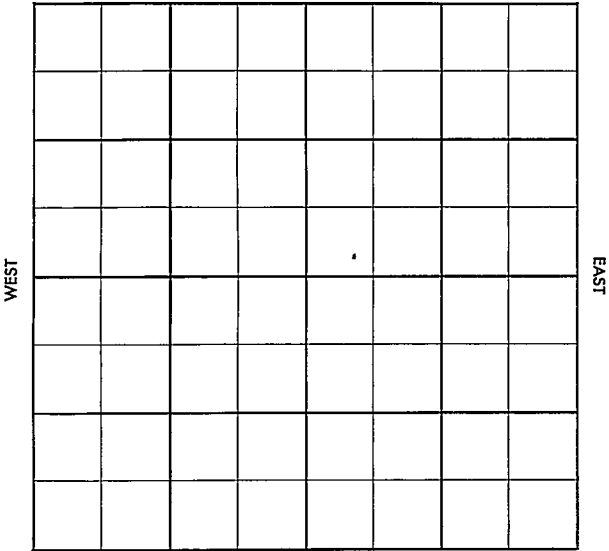

SOUTH

Ness

KANSAS

SEC.	TWP.	R.
22	18	26W

WELL NO. #1 Edwards "A" FARM

COMPANY CRA & Northern Pump

CONTRACTOR CRA


Aldrich

_____ Ft. from N. Line

1170 ~~990~~ _____ Ft. from S. Line

1650 ~~2650~~ _____ Ft. from E. Line

NE SW SE _____ Ft. from W. Line

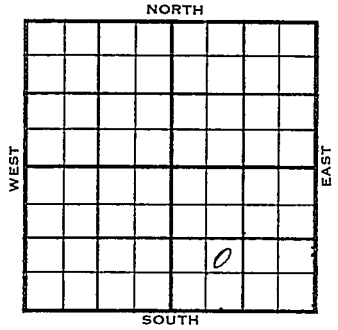

1956	ELEVATION 2543 DF	REPORT
------	----------------------	--------

4-11 ~~#####~~ Loc.
 5-9 Comm. 4-17-56
 8 5/8" @ 881 w/100
 DST 4489-94 op 1 hr. rec. 75' MW,
 BHP 1050/20"
 D & A
 H. 3805', Tr. 3822', L. 3843', ~~#####~~
 Marm 4290, Ft. Sect. 4363', Cg Cht. 4443
 M. Dolo. 4486',
 TD 4494'.
 ABANDONED

CORRECTION

FORM 513 SUNRAY

County Ness Elev. 2543 DF
2546
 Sec. 22 Twp. 18 Rge. 26W
 Company CRA & Northern Pump
 Farm Name Edwards "A" No. 1

TOPS	DEPTH	LOG	DATUM	Loc. in Sec.
Anh.				NE SW SE
Tr.				3821 50
H.	3805			1650' - I
Tr.	3822			1170 FSL Geol. 1650 FEL of Sec
Dg.				Contr.
Bl.				CRA
L.	3843			Pool
K.C.				Aldrich
B.K.C.				<div style="border: 1px dashed black; padding: 5px; display: inline-block;"> ABANDONED X X 0 X </div>
Ce.				
C. <u>Marm</u>	4290			
M. <u>Ft SCT</u>	4363			
M. <u>cg CH7</u>	4443			
K. <u>M. Dolo</u>	4486			
Mz.				
Mo.				
V.				
S.				
A.				
R.				
PE.				
G.				
TD.	4494			

Date Comm. MAY 9 1956
 Location APR 18 '56 ROR APR 25 -- 4-17-56
85/8 881/100 # 2495 MAY 2 '56
4125 MAY 9 '56 DST 4489-94 1 1/2
see 75' MW BHP 1050/20"

D&A.