Form 51—5M—9-28—27423


Russell

Map No. KANSAS Sec. 6 Twp. 13 R. 15W

Well No. 2 Leonard Farm

Texas Oil Company

NORTH

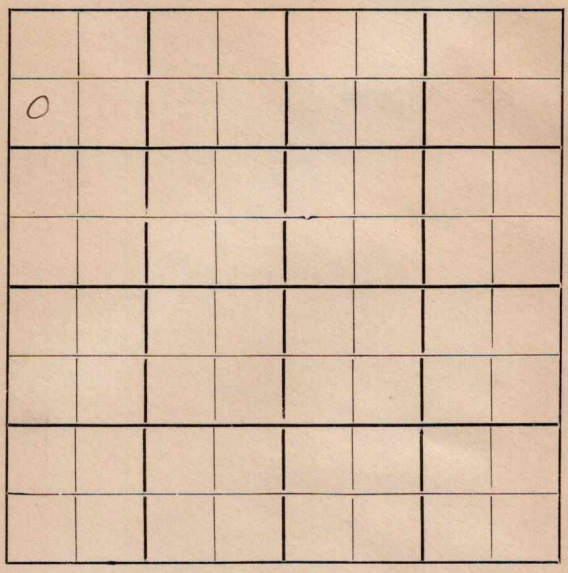

4

Location

Drilling Remarks

Rig Up

Drilling Remarks

RECORD

Cased ..... in. ..... ft.

Sand .....

Gas .....

Oil .....

Total Depth .....

PRODUCTION

1st 24 hrs. Nat. .....

1st 24 hrs. after shot .....

Gas. ..... cu. ft. .....

Dry Hole .....

Abandoned .....

Russell

Form 252A—5M—5-28—Mid-West

Map No. KANSAS Sec. 6 Twp. 13 R. 15 W

Well No. 2- Leonard Farm


Texas Oil Company

990 Ft. from N. Line

Ft. from S. Line

Ft. from E. Line

330 Ft. from W. Line

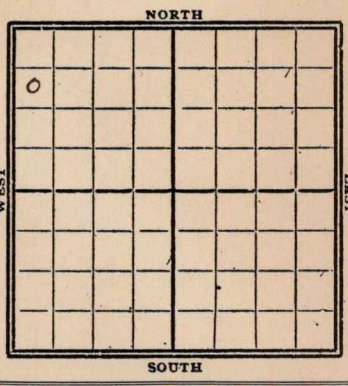

1929

Date	REPORT
6/12	Bldy Rig
6/19	—
6/26	Rig
7/2	Bldy 385
7/10	" 1000'
7/17	" 1750'
7/24	" 2485' 8"- 2367
7/31	" 2625
8/7	Sand 2992'- 3026
	T.D. 3026'
	35 bbls oil
	Comp.

Form 26—1M Bks. 6-28

Map No. KANSAS Sec. 6 Twp. 13 R. 15 W.


72

Well No. 2 Leonard

Texas Oil Company

Contractor

SECTION PLAT

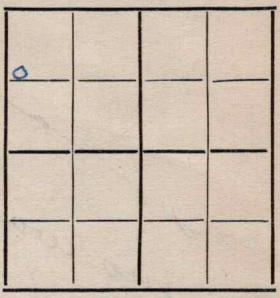

990 Ft. from N. Line

Ft. from S. Line

Ft. from E. Line

330 Ft. from W. Line

FIRST REPORTS

Location

Rig up

Drilling and Remarks:

Building rig

RECORD

Cased in., ft.

Sand

Gas

Oil

Total Depth

PRODUCTION

1st 24 hrs. Nat.

1st 24 hrs. after shot

Gas Cu. Ft.

Dry Hole

Abandoned

Date

JUN 12 1929 192

S. J. LEWIS Scout

Form 26—1M Bks.—2-29

Russell

72 KANSAS

Map No. ____ Sec. 26 Twp. 13 R. 15 W

Well No. 2 Leonard

Texas Co Company

Contractor

COMPLETE


990 Ft. from N. Line

____ Ft. from S. Line

____ Ft. from E. Line

330 Ft. from W. Line

SECTION PLAT

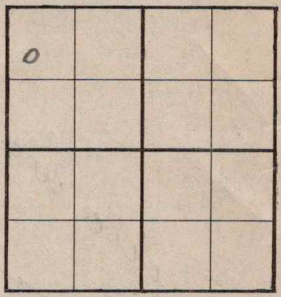

Location ____

Rig up ____

Drilling and Remarks:

35 Bbls.

RECORD

Cased ____ in., 3 ft.

Sand 2992-3026

Gas ____

Oil ____

Total Depth 3026

PRODUCTION

1st 24 hrs. Nat. ____

1st 24 hrs. after shot ____

Gas ____ Cu. Ft.

Dry Hole ____

Abandoned ____

Date

AUG 7 1929

19 ____

CHAS. L. SHERWOOD Scout