
FORM 51 25M 3-49 PETROL KANSAS Ness

Section 14 Township 18 Range 26-W

Well No. #2 Thompson

Company C R A & Harber

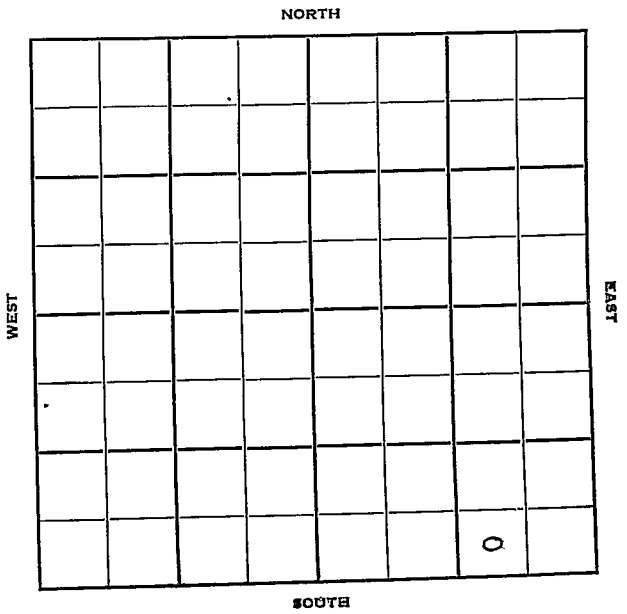

FORM 252-B
10M 9-49 PETROL

Ness KANSAS

Sec. 14 Twp. 18 R. 26W ✓

Well No. #2 Thompson Farm

C R A & Harbar Company

Harbar Drlg. Contractor

Aldrich Pool


____ Ft. from N. Line

330' Ft. from S. Line

990' Ft. from E. Line

____ Ft. from W. Line

SW SE SE

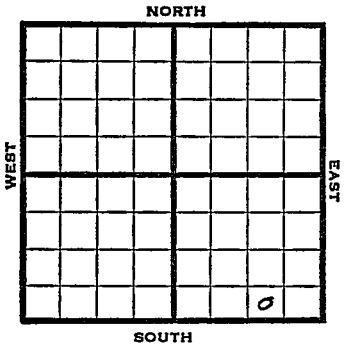

1950	Elev 2522 REPORT
9/20	Location
11/1	Spud 9-16-50 13" @ 76 Heeb 3774 Lans 3856 Miss 4435-45 5½" @ 4437 TD 4447½ 51/4437-46 1000 A S/1 bo 60% wtr S/3 bo 1 bw P/26 bo 86% wtr Comp 29 bopd 78% wtr Completed COMPLETED

FORM 275 FOR SALE BY KANSAS BLUE PRINT CO.


County Ness State Kansas

Sec. 14 (Blk. Twp.) 18 (Sur. Rge.) 26W Map No.

Operator C R A & Herbar

Well No. 2 Farm Thompson

Elev. Location SW SE SE

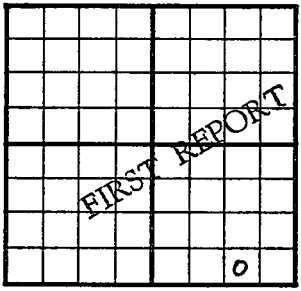

330 Ft. From S Line SE

990 Ft. From E Line Quarter

1st. Report SEP 20 1950

Completion

Remarks

Spudding Date

Drlg. Data Aldrich Pool

Location

J. E. TYRA

FORM 275 FOR SALE BY KANSAS BLUE PRINT CO.


County Ness State Kansas

Sec. 14 (Blk. Twp.) 18 (Sur. Rge.) 2 6W Map No.

Operator C R A & Harbar

Well No. 2 Farm Thompson

Elev. 2522 Location SW SE SE

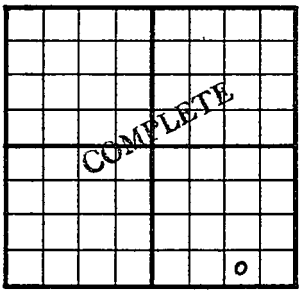

330 Ft. From S Line SE

990 Ft. From E Line Quarter

1st. Report

Completion NOV 1 1950

Remarks Aldrich Pool

Harbar Drlg. - Contr.

Spudding Date 9-16-50

Drlg. Data Oil well TD 4447½

13" @ 76 Heeb. 3774 Lans. 3856

Miss. 4435-45 5½" @ 4437 TD 4447½

51/ 4437-46 1000 A S/ 1 bo 60% water

S/ 3 bo 1 bw P/ 26 bo 86% water

Comp. 29 bopd 78% water

J. E. TYRA