

Russell

KANSAS

SECTION 6 TOWNSHIP 13 RANGE 15W


WELL NO. #1 Nowak

COMPANY VDO Oil Co.

NORTH

WEST

EAST

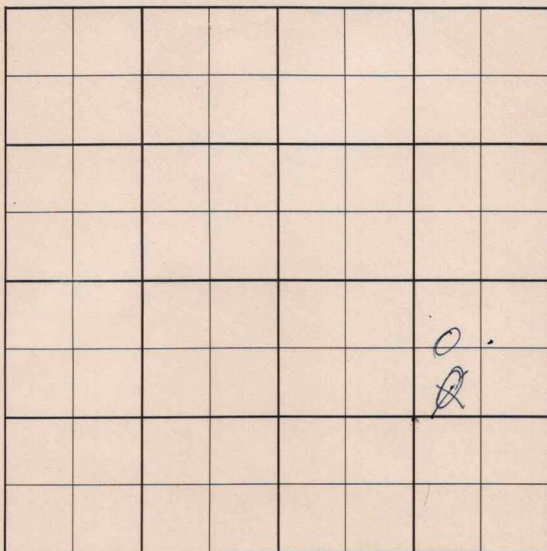

SOUTH

# WILDCAT

FORM 513 SUNRAY

County Russell Elev. \_\_\_\_\_  
Sec. 6 Twp. 13 Rge. 15W  
Company VDO Oil Co.  
Farm Name Nowak No. 1

TOPS	DEPTH	LOG	DATUM	Loc. in Sec.
Anh.				SW NE SE
TP.				
H.				
Tr.				
Dg.				
Bl.				
L.				Geol. _____
K.C.				Contr. _____
B.K.C.				
Ce.				Wickizer Tool
C.				
M.				Pool
M.				Wildcat
K.				
Mz.				
Me.				
V.				
S.				
S.				
A.				
R.				
PE.				
G.				
T.D.				

FIRST REPORT  
DEC 12 '58

Date Comm. \_\_\_\_\_  
Location \_\_\_\_\_

~~13~~

CORRECTION

FORM 518 SUNRAY

County Russell Elev. 1877  
 Sec. 6 Twp. 13 Rge. 15W  
 Company VDO Oil Co.  
 Farm Name Nowak No. 1

TOPS	DEPTH	LOG	DATUM	Loc. in Sec.
Anb.	943			SW NE SE W2
Tp.	2769			
H.	2988			
Tr.				
Dg.				
Bl.				
L.	→ 3036			Geol.
K.C.				Contr.
B.K.C.				Wickizer Tool
Ce.				Pool Fairport
C.				<del>Wickizer</del>
M.				
M.				
K.				
Mz.				
Mq.				
V.				
S.				
S.				COMPLETE
A	3300			
R.				
PE.				JAN 23 '57
G.				
TD.	3345			

Date Comm.

Location DEC 19 '56 12-16-56 8 5/8  
 290/150 WOC DEC 26 '56 JAN 2 '57 5 1/2  
 @ 3302/ JAN 9 '57 00 3309 TD  
 1/4" \$ 5 Boph no/w show in  
 69' Topeka. JAN 15 '57 \$ 6 Boph  
 JAN 23 '57 DST 2770-84 1hr new  
 140 HOCM BHP 950 DST 3040  
 -60 of 1hr on 120' HOCM BHP  
 580 DST 3300-85 of 1hr

near 40' 50cm P. 25 BOPd  
no/wtr.