


KANSAS Russell

Section 7 Township 13 Range 15W

Well No. 1 Foster

Company Rapid Drlg.

Wildcat
NORTH

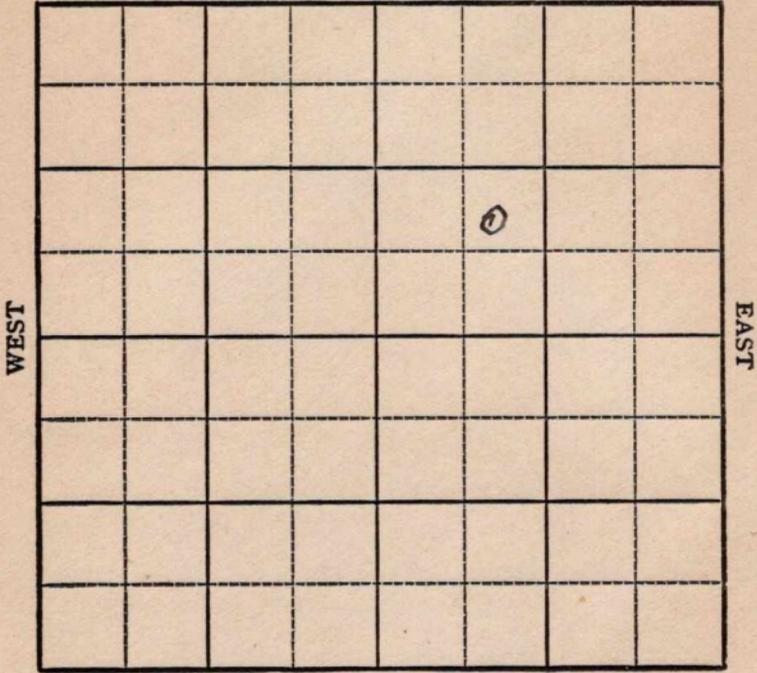

SOUTH

Sec. 7 Twp. 13 R. 15W

Well No. 1 Foster Farm

Rapid Drilling Company


Wildcat

 Ft. from N. Line

860 Ft. from S. Line

 Ft. from E. Line

750 Ft. from W. Line

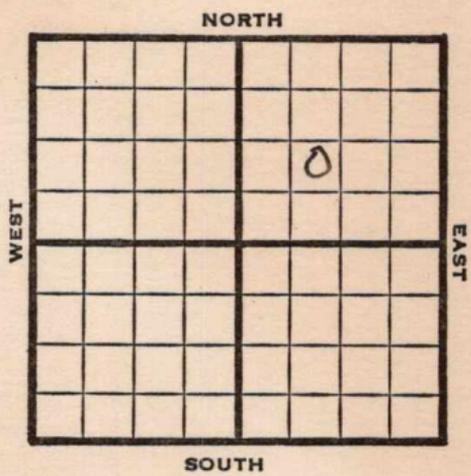

NE SW NE

1948	Eli 1886'	REPORT
9/22	Surface Hole	
9/29	8"@ 196' Drlg 2375'	
10/6	Lansing 3047' Drlg 2287'	
10/13	Arb. 3321-- TD 3330 5"@ 3321	
10/20	TD 3342' Arb. 3321' 5"@ 3321' Aband.	
ABANDONED		

Kansas

Map No. 72 Sec. 7 Twp. 13 R. 15W

Well No. 1 Foster

Rapid Drlg. Company

ABANDONED Contractor

NE SW NE

E. 1. 1876

SECTION PLAT

		8	

 Ft. from N. Line

860 Ft. from S. Line

 Ft. from E. Line

750 Ft. from W. Line

Russell County

Location

Rig up

Drilling and Remarks:

Art 3321
5" @ 3321

RECORD

Cased in., ft.

Sand

Gas

Oil

Total Depth 2342

PRODUCTION

1st 24 hrs. Nat.

1st 24 hrs. after shot

Gas Cu. Ft.

Dry Hole

Abandoned

Date

OCT 20 1948

19

S. J. LEWIS

Scout