


Russell

Map No. **KANSAS** Sec. 7 Twp 13 R. 15^w

Well No. 1 Gorham Farm
Stearns & Streeter Company

990 Ft. from N. Line
Ft. from S. Line
Ft. from E. Line
990 Ft. from W. Line

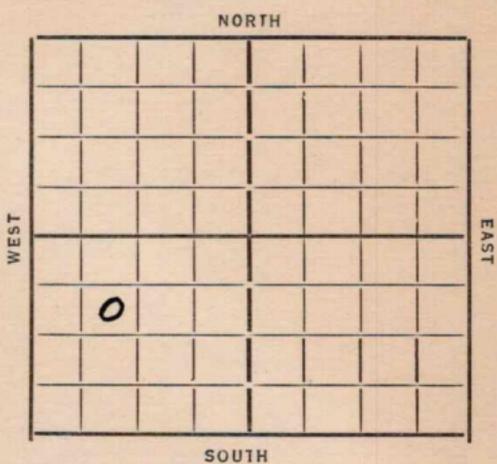

Date
1934

REPORT

<u>5/30</u>	<u>Rigged up 5D</u>
<u>6/7</u>	<u>6/14</u>
<u>6/21</u>	<u>dly 335</u>
<u>6/28</u>	<u>" 650 13" 585</u>
<u>7/5</u>	<u>" 1125 13" 999</u>
<u>7/12</u>	<u>" 1952</u>
<u>7/19</u>	<u>" 2440</u>
<u>7/26</u>	<u>dly 2695 2 7 5/8 2560-68</u>
<u>8/2</u>	<u>W R 8" 2810</u>
<u>8/9</u>	<u>dly 2835 8" 2822</u>
<u>8/16</u>	<u>_____</u>
<u>8/23</u>	<u>6" 3131 HFW 3169</u>
	<u>Top cswell 3138 dly 3246</u>
<u>8/30</u>	<u>S.O. 3305 dly 3341</u>
<u>9/6</u>	<u>No hope</u>
<u>9/13</u>	<u>3423 5D</u>
<u>9/20</u>	<u>No hope</u>
<u>9/26</u>	<u>cswell 3138- TD 3423 D/A</u>

ABANDONED

Russell

Map No. 72 **KANSAS** Sec. 7 Twp. 13 R. 15W

Well No. 1 *Godman*

Steam & Drilling Company

Contractor

SECTION PLAT

FIRST REPORTS

990 Ft. from N. Line

_____ Ft. from S. Line

_____ Ft. from E. Line

990 Ft. from W. Line

Location _____

Rig up _____

Drilling and Remarks:

*Rigged up
Well*

RECORD

Cased _____ in., _____ ft.

Sand _____

Gas _____

Oil _____

Total Depth _____

PRODUCTION

1st 24 hrs. Nat. _____

1st 24 hrs. after shot _____

Gas _____ Cu. Ft.

Dry Hole _____

Abandoned _____

Date

ORVAL MANNSCHRECK

5/30 1934

Scout

KANSAS

Map No. 72 Sec. 7 Twp. 13 R. 15W

Well No. 1-Gorham

Stearns & Street Company

Contractor

ABANDONED

SECTION PLAT

990 Ft. from N. Line

_____ Ft. from S. Line

_____ Ft. from E. Line

990 Ft. from W. Line

Location _____

Rig up _____

Drilling and Remarks:

NO & H

RECORD

Cased _____ in., _____ ft.

Sand Orval 3138

Gas _____

Oil _____

Total Depth 3423

PRODUCTION

1st 24 hrs. Nat. _____

1st 24 hrs. after shot _____

Gas _____ Cu. Ft.

Dry Hole _____

Abandoned _____

Date

9-26-31

ORVAL MANNSCHRECK

Scout