

Ness


KANSAS

SECTION 23 TOWNSHIP 18 RANGE 26 W

WELL NO. #1 Harkness "C"

COMPANY C R A & Grant Oil

NORTH

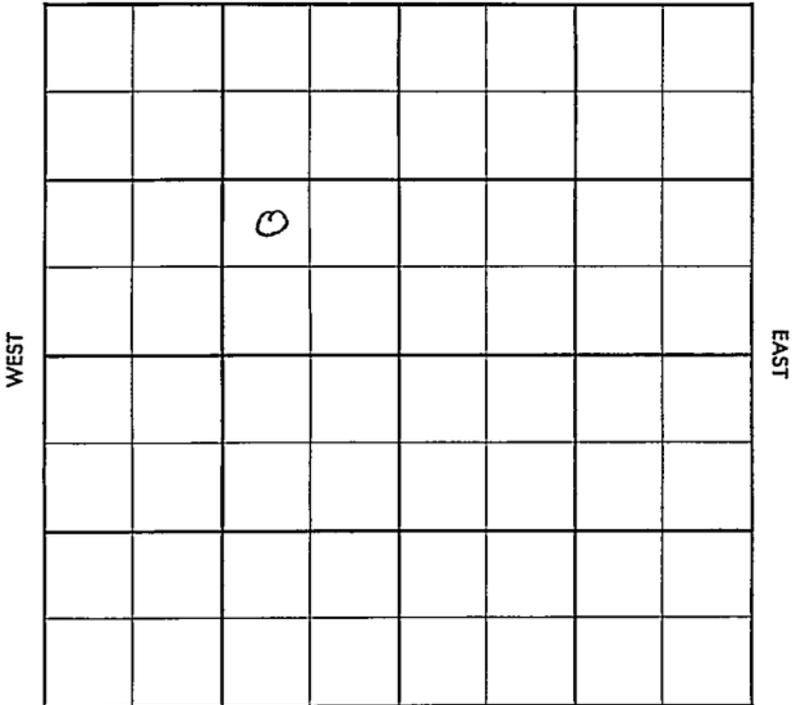

SOUTH

Ness

KANSAS

SEC. 23	TWP. 18	R. 26W
------------	------------	-----------

WELL NO.

#4 Harkness "C"

FARM

COMPANY

CRA & Grant Oil

CONTRACTOR

CRA

Aldrich


1630 Ft. from N. Line

Ft. from S. Line

Ft. from E. Line

1517 Ft. from W. Line

NW SE NW

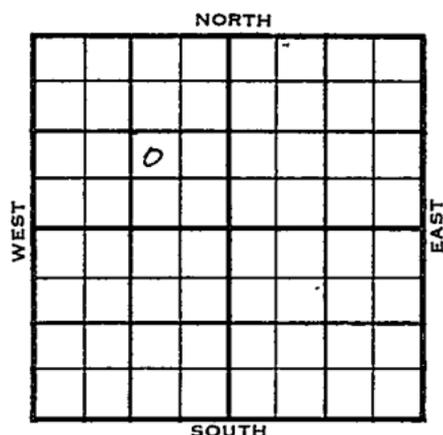

	ELEVATION	REPORT
1955	2574'	
12-14	MIR	
1956		
2-1	Comm. 12-13-55 8 5/8" @ 85/100 Dst 4486-92 op 1 hrs. rec. 30' mud, 0/20" DST 4487-97 op 1 hr. rec. 25' mud, 350/20" DST 4493-4501 op 1 hr. rec. 60' hocm 800/20" 5 1/2" @ 4561 CO. to 4525, 20/ 4493-99 wtr. 12/ 4487-90, 1 1/2 gw 4 hrs., 500 A S/ 29 bo 106 bw, 12 hrs. Comp. 25' bopd, 76% wtr. H. 3821 3829 Tr. 3844- 3847 L. 3866 3869 Marm 4314 4316 Ft.Scott 4378 4383 Ce. 4418 4410 C. 4472 Dolo 4485 4484 TD 4561'	

COMPLETED

County Ness Elev. _____
 Sec. 23 Twp. 18 Rge. 26W
 Company C R A & Grant Oil
 Farm Name Harkness "C" No. 4

TOPS	DEPTH	LOG	DATUM
Anh.			
Tp.			
H.			
Tr.			
Dg.			
Bl.			
L.			
K.C.			
B.K.C.			
Ce.			
C.			
M.			
M.			
K.			
Mz.			
Ma.			
V.			
S.			
S.			
A.			
R.			
Pe.			
G.			
T.D.			

Loc. in Sec. NW SE NW
1630' NL
1517' WL
 Geol. _____
 Contr. G R A
 Pool Aldrich

	0	
FIRST REPORT		
	DEC 14 '58	

Date Comm. M I R

[Handwritten signature]

Co.
Lse.
No.
Sec.
T.
R.

County Ness Elev. 2574
 Sec. 23 Twp. 18 Rge. 26W
 Company C R A & Grant Oil
 Farm Name Harkness "C" No. 4

TOPS	DEPTH	LOG	DATUM	Loc. in Sec.
Anb.				NW SE NW
Tr.				1630' NL
H.	<u>3821</u>	<u>3829</u>		1517' WL
Tr.	<u>3844</u>	<u>3847</u>		
Dg.				
Bl.				
L.	<u>3866</u>	<u>3869</u>	<u>1295</u>	
K.C. <u>Wasm</u>	<u>4314</u>	<u>4316</u>	<u>1742</u>	Geol.
B.K.C. <u>JT Scott</u>	<u>4378</u>	<u>4383</u>	<u>1809</u>	Contr.
Ce.	<u>4418</u>	<u>4410</u>	<u>1836</u>	C R A
C.		<u>4472</u>	<u>1898</u>	
M. <u>Dolo</u>	<u>4485</u>	<u>4484</u>	<u>1910</u>	Pool
M.				Aldrich
K.				
Mz.				
Mq.				
V.				
S.				
S.				
A.				
R.				
Pe.				
G.				
T.D.	<u>4561</u>	<u>4561</u>		

COMPLETE

Date Comm. 12-13-55 FEB 1 1956
8 5/8" @ 85/100 DST 4486-92 open
1 hr. rec. 30' mud 0/20"
DST 4487-97 open 1 hr. rec. 25' mud
350/20" DST 4493-4501 open 1 hr.
rec. 60' hocm 800/20" 5 1/2" @ 4561
CO to 4525 20/ 4493-99 wtr.
12/ 4487-90 1 1/2 gw 1 hr. 500 A

S/ 29 bo 106 bw 12 hr.

Comp. 25 bopd 76% wtr.

R. G.

FEB 9 1956