


Map No. *KANSAS* Sec. *8* Twp. *13* R. *15<sup>w</sup>*

Well No. *1-Drilling* Farm

*Stearns & Sheets* Company

*Russell*

NORTH

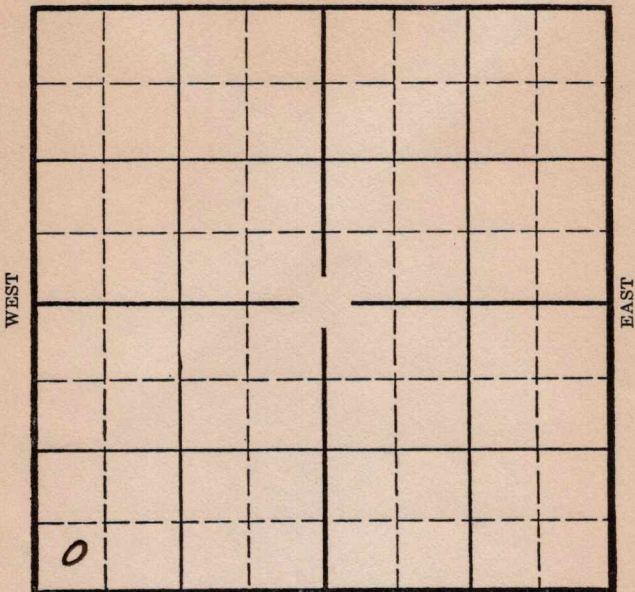

SOUTH

Location \_\_\_\_\_  
Drilling Remarks \_\_\_\_\_

Rig Up \_\_\_\_\_  
Drilling Remarks \_\_\_\_\_

\_\_\_\_\_  
\_\_\_\_\_  
RECORD

PRODUCTION

Cased \_\_\_\_\_ in. \_\_\_\_\_ ft.  
Sand \_\_\_\_\_  
Gas \_\_\_\_\_  
Oil \_\_\_\_\_  
Total Depth \_\_\_\_\_

1st 24 hrs. Nat. \_\_\_\_\_  
1st 24 hrs. after shot \_\_\_\_\_  
Gas \_\_\_\_\_ cu. ft. \_\_\_\_\_  
Dry Hole \_\_\_\_\_  
Abandoned \_\_\_\_\_


Russell  
13 15<sup>w</sup>

Map No. KANSAS Sec. 8 Twp. 13 R. 15<sup>w</sup>

Well No. 1 - Drilling Farm

Stearns & Shute Company

NORTH

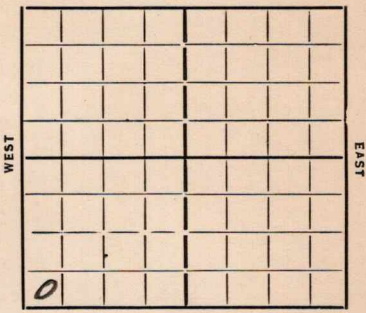

Ft. from N. Line

330 Ft. from S. Line

Ft. from E. Line

330 Ft. from W. Line

Elev. 1918

Date

REPORT

6/5	Location	
6/13	— 670 —	
6/28	A.R.	
7/5	—	
7/14	big	
7/18	—	
8/8	Alg 1815	
8/15	" 3185	
8/22	" 2585	10" 2453
8/29	" 2794	8" 2783
9/6	" 2940	
9/20	Sil 3364	
	T 3386	

J. A.

ABANDONED

Map No. 72 Sec. 8 Twp. 13 R. 15W

Well No. 1-Drilling

Stearns + Strutt Company

Contractor

FIRST REPORTS

SECTION PLAT

.....Ft. from N. Line

330 Ft. from S. Line

.....Ft. from E. Line

330 Ft. from W. Line

0			

Location..... ✓

Rig up.....

Drilling and Remarks:.....

RECORD

Cased.....in., .....ft.

Sand.....

Gas.....

Oil.....

Total Depth.....

PRODUCTION

1st 24 hrs. Nat.....

1st 24 hrs. after shot.....

Gas.....Cu. Ft.

Dry Hole.....

Abandoned.....

Date

6-5-35 192

Scout

ORVAL MANNSCHECK

Map No. 72 Sec. 8 Twp. 13 R. 15W

Well No. 1-Drilling

Stearns + Struten Company

Contractor

ABANDONED KANSAS

SECTION PLAT

0			

Ft. from N. Line

330

Ft. from S. Line

Ft. from E. Line

330

Ft. from W. Line

Location.....

Rig up.....

Drilling and Remarks:

OTA

RECORD

Cased.....in.....ft.

Sand Sil 3364

Gas.....

Oil.....

Total Depth 3386

PRODUCTION

1st 24 hrs. Nat.....

1st 24 hrs. after shot.....

Gas.....Cu. Ft.

Dry Hole.....

Abandoned.....

Date

9-20-35

192.....

ORVAL MANNSCHRECK

Scout