

Section 24 Township 18 Range 26WWell No. #1 Sutton "A"Company C.R.A.

NORTH

	0						

WEST

EAST

SOUTH

Ness KANSAS

SEC	TWP.	R.
24	18	26W

WELL NO.

1 Sutton "A"

FARM

COMPANY

C R A

CONTRACTOR

CRA


Aldrich Pool

_____ Ft. from N. Line

330 _____ Ft. from S. Line

_____ Ft. from E. Line

990 _____ Ft. from W. Line

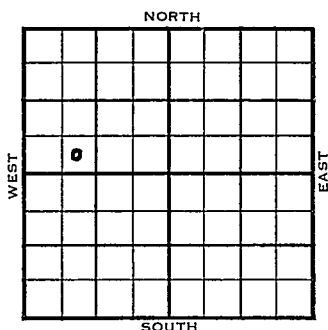


SE SW NW

	ELEVATION	REPORT
1954	2543'	
4/14 5/5	MIR	10" @ 78' w/100 sks Heeb 3795', Tor 3813', Lans 3875', Ft. Scott 4338', Cherokee 4363', Cong 4418', Miss 4442', DST 4444-54', 1 hr., 60' MCO, 90' GCO, 270' gas, 700# RTD 4454' 5" @ 4444'
5/12	CO 4454'	B/5.7 BO 11 hrs., 1000A 52½ BO 11 hrs. P/39 BO 8 hrs. 1% wtr.
5/12 5/23	NE Spud 4-14-54	Oil well TD 4454 10" @ 78 Heeb 3795 Tor. 3813 Lans 3875 Ft. Scott 4338 Cherokee 4363' Cong. 4418 Miss 4442 DST 4444-54 open 1 hr. rec 60' MCO 90' GCO, 270' gas 700# TD 4454 5" @ 4444 CO to 4454 B/5.7 BO 11 hr 1000 A 52½ BO 11 hr. P/39 BO 8 hr. 1% wtr. P/33 BO 16½ hr. 1% wtr. Comp. 102 BOPD

COMPLETED

County Ness State Kansas
 Sec. 24 (Blk.) 18 (Sur.) 26W Map No.
 Operator CRA
 Well No. 1 Farm Sutton "A"
 Elev. _____ Location SE SW NW

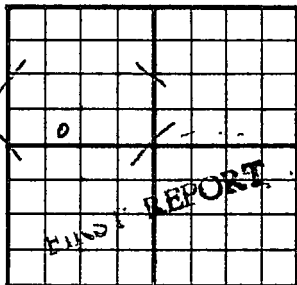

330 Ft. From S Line NW
990 Ft. From W Line Quarter
 1st. Report APR 14 1954

Completion _____

Remarks _____

CRA - Contr.

Spudding Date _____


Drlg. Data _____

Aldrich Pool

M I R

J. G. McGEHEE

County Ness State Kansas
 Sec. 24 (Blk. Twp.) 18 (Sur. Rge.) 26W Map No. _____
 Operator C R A
 Well No. 1 Farm Sutton "A"
 Elev. 2543 Location SE SW NW

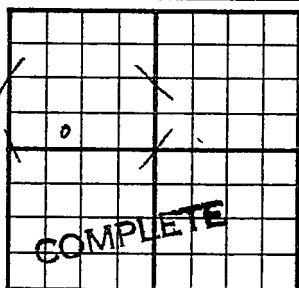

330 Ft. From S Line NW
 990 Ft. From W Line Quarter
 1st. Report _____
 Completion JUN 23 1954
 Remarks Aldrich Pool
CRA - Contr.
 Spudding Date 4-14-54

Drlg. Data Oil well TD 4454
10" @ 78 Heeb. 3795 Tor. 3813
Lans. 3875 Ft. Scott 4338 Cherokee 4363
Cong. 4418 Miss. 4442 DST 4444-54
open 1 hr. Rec. 60' mco 90' gco
270' gas 700# TD 4454 5" @ 4444
CO to 4454 B/ 5.7 bo 11 hr. 1000 A
52½ bo 11 hr. P/ 39 bo 8 hr. 1% wtr.
P/ 33 bo 16½ hr. 1% wtr.
Comp. 102 bopd

J. G. McGEHEE