

DX 78-1


Ness

KANSAS

Section 24 Township 18 Range 26W

Well No. #2 Sutton "A"

Company CRA

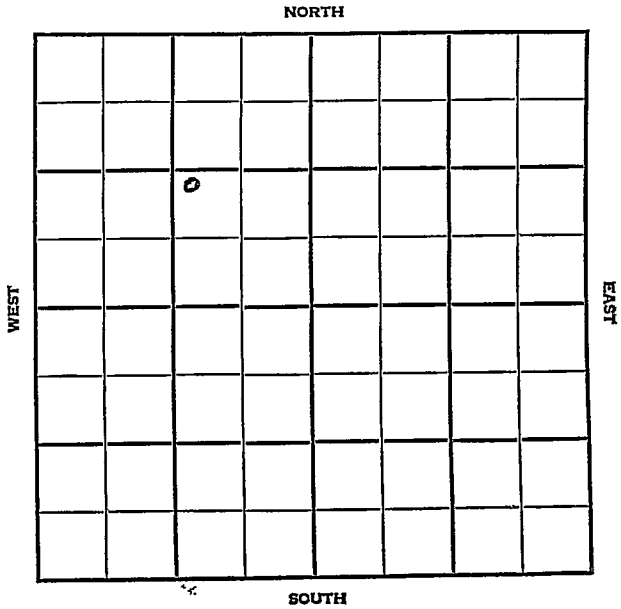

Ness

KANSAS


SEC. 24	TWP. 18	R. 26W
------------	------------	-----------

WELL NO. #2 Sutton FARM

COMPANY C. R. A.

CONTRACTOR C. R. A.

_____ Ft. from N. Line
 _____ Ft. from S. Line
 _____ Ft. from E. Line
 _____ Ft. from W. Line

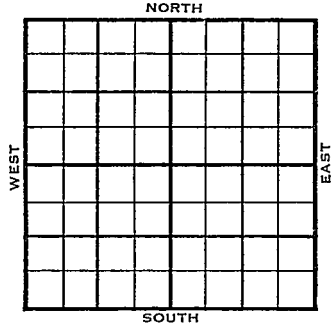

NW SE NW

1955	ELEVATION 2546	REPORT
------	-------------------	--------

6/1
 Comm 3-16-55
 8": 87/100 cored 4418-38 Rec. 19'
 Cored 4438-56 Rec. 18' DST 447-56
 open 1 hr. Rec. 810' gas 500' clean
 oil 200/20" TD 4456 5 1/2" @ 4447
 CO 4447 FU 400' oil 2 hr. S/5.22
 bo 1 hr. 2000 A S/19.63 boph 8 hr.
 P/69 bo 5% bsw 15 hr. P/100 bo 2%
 bsw 24 hr. Comp. 100 bopd 2% bsw

	DEPTH	DATUM
H.	3796	1250
Tr.	3815	1269
L.	3876	1330
K.C.	4341	1795
Ce.	4368	1822
M.	4446	1900
TD.	4456	

FIRST REPORT
 ✓
 COMPLETED

County Ness Elev. 2546
 Sec. 24 Twp. 18 Rge. 26W
 Company C R A
 Farm Name Sutton "A" No. 2

TOPS	DEPTH	LOG	DATUM	Loc. in Sec.
Anh.				NW SE NW
TP.				
H.	<u>3796</u>		<u>1250</u>	
Tr.	<u>3815</u>		<u>1269</u>	
Dg.				
BL.				
L.	<u>3876</u>		<u>1330</u>	Geol.
K.C. <u>7+ Scott</u>	<u>4341</u>		<u>1795</u>	Contr.
B.K.C.				<u>C R A</u>
Ce.	<u>4368</u>		<u>1822</u>	Pool
C.				
M.	<u>4446</u>		<u>1900</u>	
M.				
K.				
Mz.				
Me.				
V.				
S.				
S.				
A.				
R.				
PE.				
G.				
TD.	<u>4456</u>			

FIRST REPORT

COMPLETE

Date Comm. 3-16-55 JUN 1 1955

8" @ 87/100 Cored 4418-38 Rec. 19'

Cored 4438-56 Rec. 18' DST 4447-56

open 1 hr. Rec. 810' gas 500' clean oil

200/20" TD 4456 5 $\frac{1}{2}$ " @ 4447.

CO 4447 FU 400' oil 2 hr. S/ 5.22 bo

1 hr. 2000 A S/ 19.63 boph 8 hr.

P/ 69 bo 5% bsw 15 hr. P/ 100 bo

2% bsw 24 hr.

Comp. 100 bopd 2% bsw