

DX 78-1


Ness

KANSAS

Section 24 Township 18 Range 26W

Well No. #2 Stella Sutton

Company Tennessee Gas Transmission

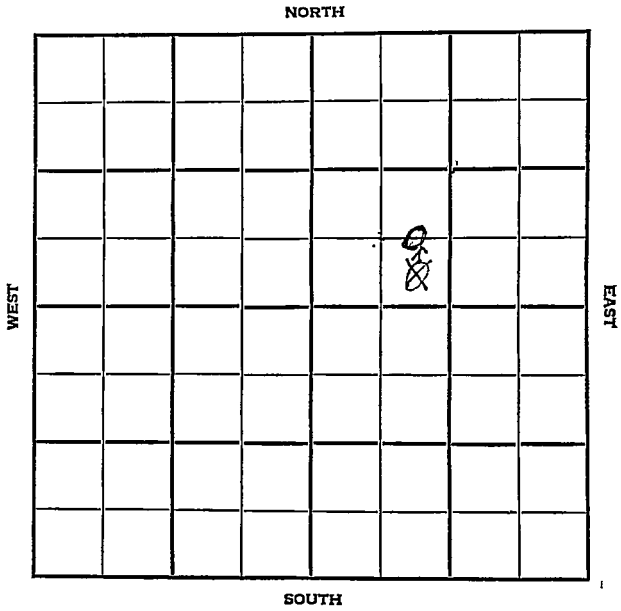

County Neels Elev. _____
 Sec. 21; Twp. 18 Rgs. 26W
 Company Tennessee Gas Transmission
 FarmName Stella Sutton No. 2

TOPS	DEPTH	LOG	DATUM
Anh.			
Tp.			
H.			
Tr.			
Dg.			
BL.			
L.			
K.C.			
B.K.C.			
Ce.			
C.			
M.			
M.			
K.			
Mz.			
Mo.			
V.			
S.			
S.			
A.			
R.			
PE.			
G.			
T.D.			

Loc. in Sec. _____
SE SW NE
 Geol. _____
 Contr. _____
Sterling
 Pool _____
A Idrich

FIRST REPORT

JAN 9 57

Date Comm. 1-4-57
8" @ 899 drlg. 1735

~~55~~

Co.
Lse.
No.
Sec.
T.
R.

CORRECTION

FORM 813 SUNRAY

County	Ness	Elev.	20575
Sec.	21	Twp.	18
Company	Tennessee Gas Transmission		
Farm Name	Stella Sutton		No. 2

TOPS	DEPTH	LOG	DATUM	Loc. in Sect.
Anh.	4229			E 2 SW NE
Tr.	3774			SR - SW NE
Dg.	3792			2100' FNL
Bl.				1530' FEL
L.				Geol.
K.C.	3816			Contr.
B.K.C.				Sterling
Ce.	4324			Pool
C.	4400			A Idrich
M.	4424			
M.				
K.				
Mz.				
Me.				
V.				
S.				
S.				
A.				
R.				
PE.				
G.				
T.D. #	4483			COMPLETE

Date Comm. 1-11-57
 8" @ 899 drls 1735 ϕ 2770

JAN 23 57 ϕ 4085 JAN 30 57
 DST 4425-36 1hr 75' gas
 rec 290' VHO CM BHP 1120/20"
 5 1/2 @ 4984 FEB 6 57 Co PB 4450
~~3000~~ 4423-31 S. 12 B0 n/w
 16 hrs A/Ted + 141 DF 12
 13 hrs (25% w/w) Feb 13 57
 FEB 20 57 P. 23 B0 + 121 BW 29 hrs
 P. 25 B0 rd + 15 BWP