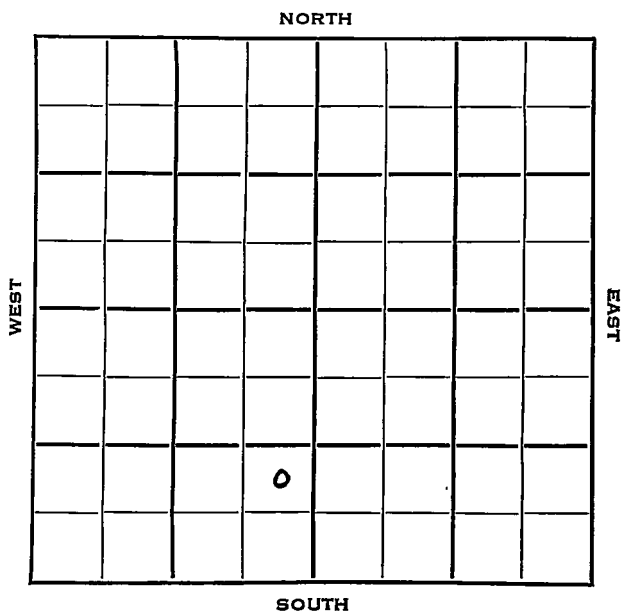



Rice KANSAS

Section 24 Township 18 Range 10 WWell No. # 1 CulbertsonCompany Vickers Exploration Ltd.

Rice KANSAS ✓

Sec. 24 Twp. 18 R. 10WWell No. #1 Culbertson FarmVickers Exploration Ltd. CompanyJayhawk Contractor
Farmer Pool (Ext) Ft. from N. Line990 Ft. from S. Line330 Ft. from E. Line Ft. from W. Line

NE SE SW

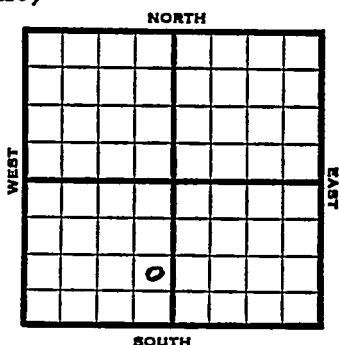

1953 Elev. 1741' REPORT

5/13 Spud 5-11-53
8" @ 209', WOC5/21 Anhy 415'
Drlg. 2885'5/28 Heeb 2746, Br. L. 2869, Lans 2888,
Cong 3210, Arb 3230
RTD 3235
5" @ 3232'6/3 CO 3235 S/ 11 boph 3 hrs, 500 A
no help S/ 4 boph $\neq$ 2% w. DD 3238
TD S/ 4 boph $\neq$ 2%

6/10 N.R.

6/24 "

7/1 "

7/8 Spud 5-11-53, Oil Well
TD 3238

8" @ 209'

Anhy 415, Heeb 2746, Br Lime 2869, Lans
2888, Cong 3210, Arb. 3230

TD 3235


5" @ 3232, CO to 3235

S/11 bo 3 hrs., 500A, S/4 boph 2% wtr
DD 3238, S/4 boph 2% wtr.

Comp 91 bopd

COMPLETED

County Rice State Kansas
 Sec. 24 (Blk.) 18 (Sur.) 10W Map No.
 (Twp.) (Rge.)
 Operator Vickers Exploration Ltd.
 Well No. 1 Farm Culbertson
 Elev. Location NE SE SW

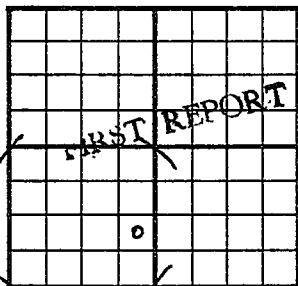

990 Ft. From S Line SW
330 Ft. From E Line Quarter

1st. Report MAY 13 1953

Completion

Remarks

Jayhawk - Contr.

Spudding Date 5-11-53


Drig. Data

Farmer Pool (Ext)

8" @ 209 WOC

J. G. McGEHEE

County Rice State Kansas
 Sec. 24 (Blk.
Twp.) 18 (Sur.
Rge.) 10W Map No.
 Operator Vickers Exploration Ltd.
 Well No. 1 Farm Culbertson
 Elev. 1741 Location NE SE SW

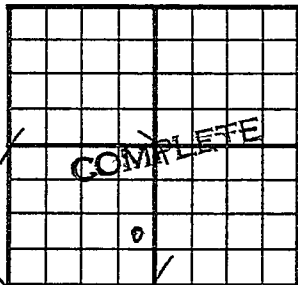

990 Ft. From S Line SW

330 Ft. From E Line Quarter

1st. Report

Completion JUL 8 1953

Remarks Farmer Pool (ext)

Jayhawk - Contr.

Spudding Date 5-11-53

Drig. Data Oil well TD 3238

8" @ 209 Anhy 415 Heeb. 2746

Br. lime 2869 Lans. 2888 Cong. 3210

Arb. 3230 TD 3235 5" @ 3232 CO to 3235

S/ 11 bo 3 hr. 500 A S/ 4 boph 2% wtr.

DD 3238 S/ 4 boph 2% wtr.

Comp. 91 bopd

J. G. McGEHEE